

BP 17-19

CITY OF CRAIG, ALASKA BUILDING PERMIT APPLICATION

Applicant Information

Owner Information (if not also applicant)

Name JAMES CARLE
Mailing Address P.O. BOX 1163
Street Address 506 625th
City, State, Zip Craig AK 99921
Telephone 907-826-3236

Name _____
Mailing Address _____
Street Address _____
City, State, Zip _____
Telephone _____

Property Description

Subdivision Name _____
Survey Number: USS1430 Tract Number: _____ Lot Number: 2A Block Number: 12
Army Corps of Engineers Permit Name and/or Number: _____

Building Activity Information (please check one)

- | | | | |
|---|-----------------------------------|---|--|
| <input type="checkbox"/> Single Family Home | <input type="checkbox"/> Duplex | <input type="checkbox"/> Triplex | <input type="checkbox"/> Fourplex or greater |
| <input checked="" type="checkbox"/> Deck | <input type="checkbox"/> Porch | <input type="checkbox"/> Retaining Wall | <input type="checkbox"/> Addition |
| <input type="checkbox"/> Commercial Building | <input type="checkbox"/> Wannigan | <input type="checkbox"/> Garage | <input type="checkbox"/> Shed |
| <input checked="" type="checkbox"/> Mobile Home (Year and Make) _____ | | | |
| <input type="checkbox"/> Travel Trailer (Year and Make) _____ | | | |
| <input type="checkbox"/> Other (Please describe): _____ | | | |

Height of Building at Roof Eve: _____

Closest setback to property line: _____

Building Dimensions: _____

Area of building footprint: _____

What use(s) do you propose for the building? _____

Site Plan

Please complete on reverse side or attached sheet a site plan showing all proposed construction.

Owner's/Applicant's Statement

I acknowledge that I have read this application and state that the above information is correct. I agree to comply with all codes and ordinances of the City of Craig applicable to building and construction, and all land use regulations as pertaining to this permit. Any violation of land management regulations are the responsibility of the property owner. This permit becomes void upon completion of the approved work, or one year, whichever comes first. Work not documented in this application is not authorized by this building permit.

I understand that this permit is revocable if work is not completed consistent with this applicant or if work does not comply with the requirements of the City of Craig Municipal Code.

I agree to provide the City of Craig with an as-built survey of the lot in the event one is completed for this project.

Signature of Applicant JAMES CARLE Date 8-15-2019

Approved by Laurie Carrick
by phone 8/14/19 (80)
Signature of Property Owner (if other than applicant) Date

Special Conditions of Approval.

The following conditions of approval are made a part of this permit as provided by section 18.06.001B.6 of the Craig Land Development Code:


- #1. Trailer must measure a minimum of 38' from the fence to the rear corner of the structure.
- #2. No walls or decks above 30" from ground within 10' of any property line.
- #3. Trailer must be skidded & hooked up to city utilities.

Permission is hereby granted to perform the above work in compliance with any and all conditions listed above and in compliance with the Craig Land Development Code and all other ordinances of the City of Craig and the State of Alaska pertaining to the construction of buildings.

Signature of City Building Official [Signature]

Date 8/14/19

BP 17-19

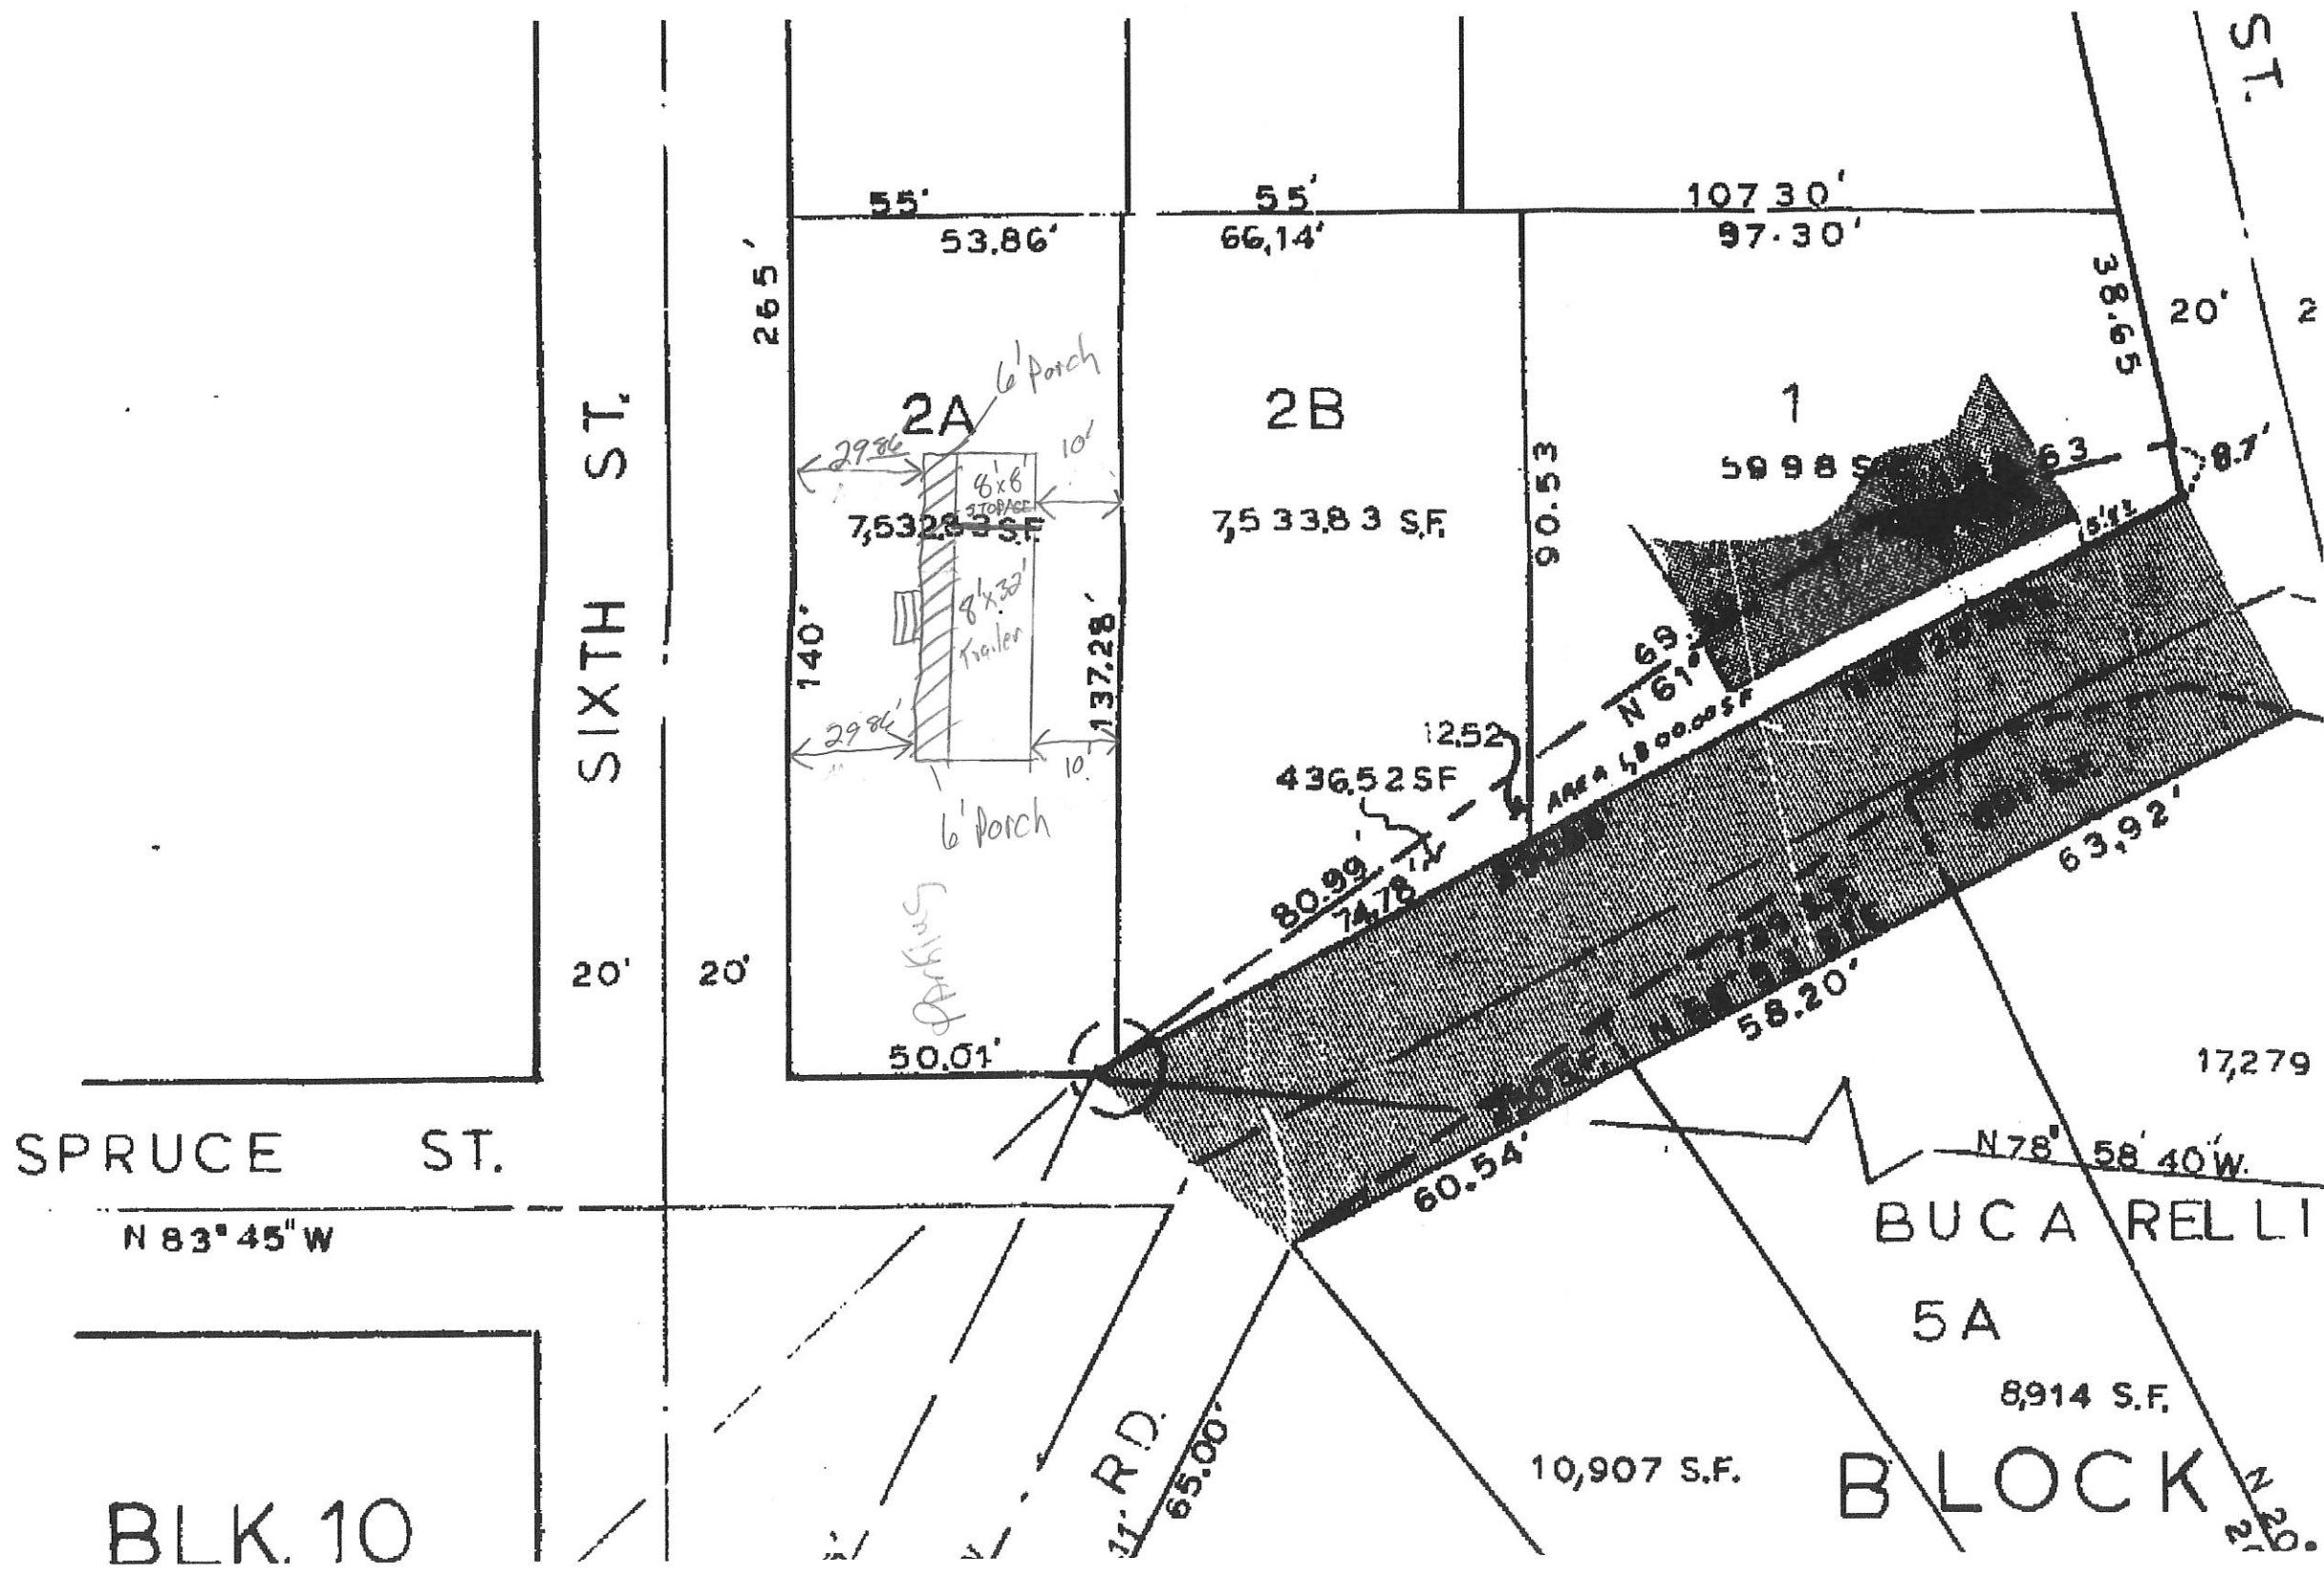

Plat # 79-29

RECORDED - FILED *3*
W. H. K. R. W. REC. DIST.
 DATE *19/8* 19 *77*
 TIME *2:35* P. M.
 Requested by *City of Cary*

SIXTH ST.

SPRUCE ST.

BLK. 10

BUCA RELLI
 5A
 8,914 S.F.
 BLOCK

SIXTH ST.

ST.