

CITY OF CRAIG, ALASKA BUILDING PERMIT APPLICATION

Applicant Information

Name Adelbert L. Clark
Mailing Address P.O. Box 403
Street Address 704 East Bayview Blvd.
City, State, Zip Craig, AK
Telephone 907 1826-3031

Owner Information (if not also applicant)

Name Sonnie Anderson
Mailing Address P.O. Box 83
Street Address _____
City, State, Zip Craig, Alaska 99921
Telephone _____

Property Description

Subdivision Name _____
Survey Number: _____ Tract Number: _____ Lot Number: 19 B Block Number: _____
Army Corps of Engineers Permit Name and/or Number: _____

Building Activity Information (please check one)

- Single Family Home
- Deck
- Commercial Building
- Mobile Home (Year and Make) _____
- Travel Trailer (Year and Make) _____
- Other (Please describe): _____
- Duplex
- Porch
- Wannigan
- Triplex
- Retaining Wall
- Garage
- Fourplex or greater
- Addition
- Shed

Height of Building at Roof Eave: _____ Closest setback to property line: _____

Building Dimensions: 12x60 Area of building footprint: _____

What use(s) do you propose for the building? _____

Site Plan

Please complete on reverse side or attached sheet a site plan showing all proposed construction.

Owner's/Applicant's Statement

I acknowledge that I have read this application and state that the above information is correct. I agree to comply with all codes and ordinances of the City of Craig applicable to building and construction, and all land use regulations as pertaining to this permit. Any violation of land management regulations are the responsibility of the property owner. This permit becomes void upon completion of the approved work, or one year, whichever comes first. Work not documented in this application is not authorized by this building permit. I understand that this permit is revocable if work is not completed consistent with this applicant or if work does not comply with the requirements of the City of Craig Municipal Code. I agree to provide the City of Craig with an as-built survey of the lot in the event one is completed for this project.

Adelbert L. Clark 3/8/2015
Signature of Applicant Date

Sonnie Anderson 3-12-15
Signature of Property Owner (if other than applicant) Date


Special Conditions of Approval.

The following conditions of approval are made a part of this permit as provided by section 18.06.001B.6 of the Craig Land Development Code:

#1. Permit covers placement of trailer, wannigan, skirting & other construction related to placement of trailer.

Permission is hereby granted to perform the above work in compliance with any and all conditions listed above and in compliance with the Craig Land Development Code and all other ordinances of the City of Craig and the State of Alaska pertaining to the construction of buildings.

Brian [Signature] Date 3/23/15
Signature of City Building Official

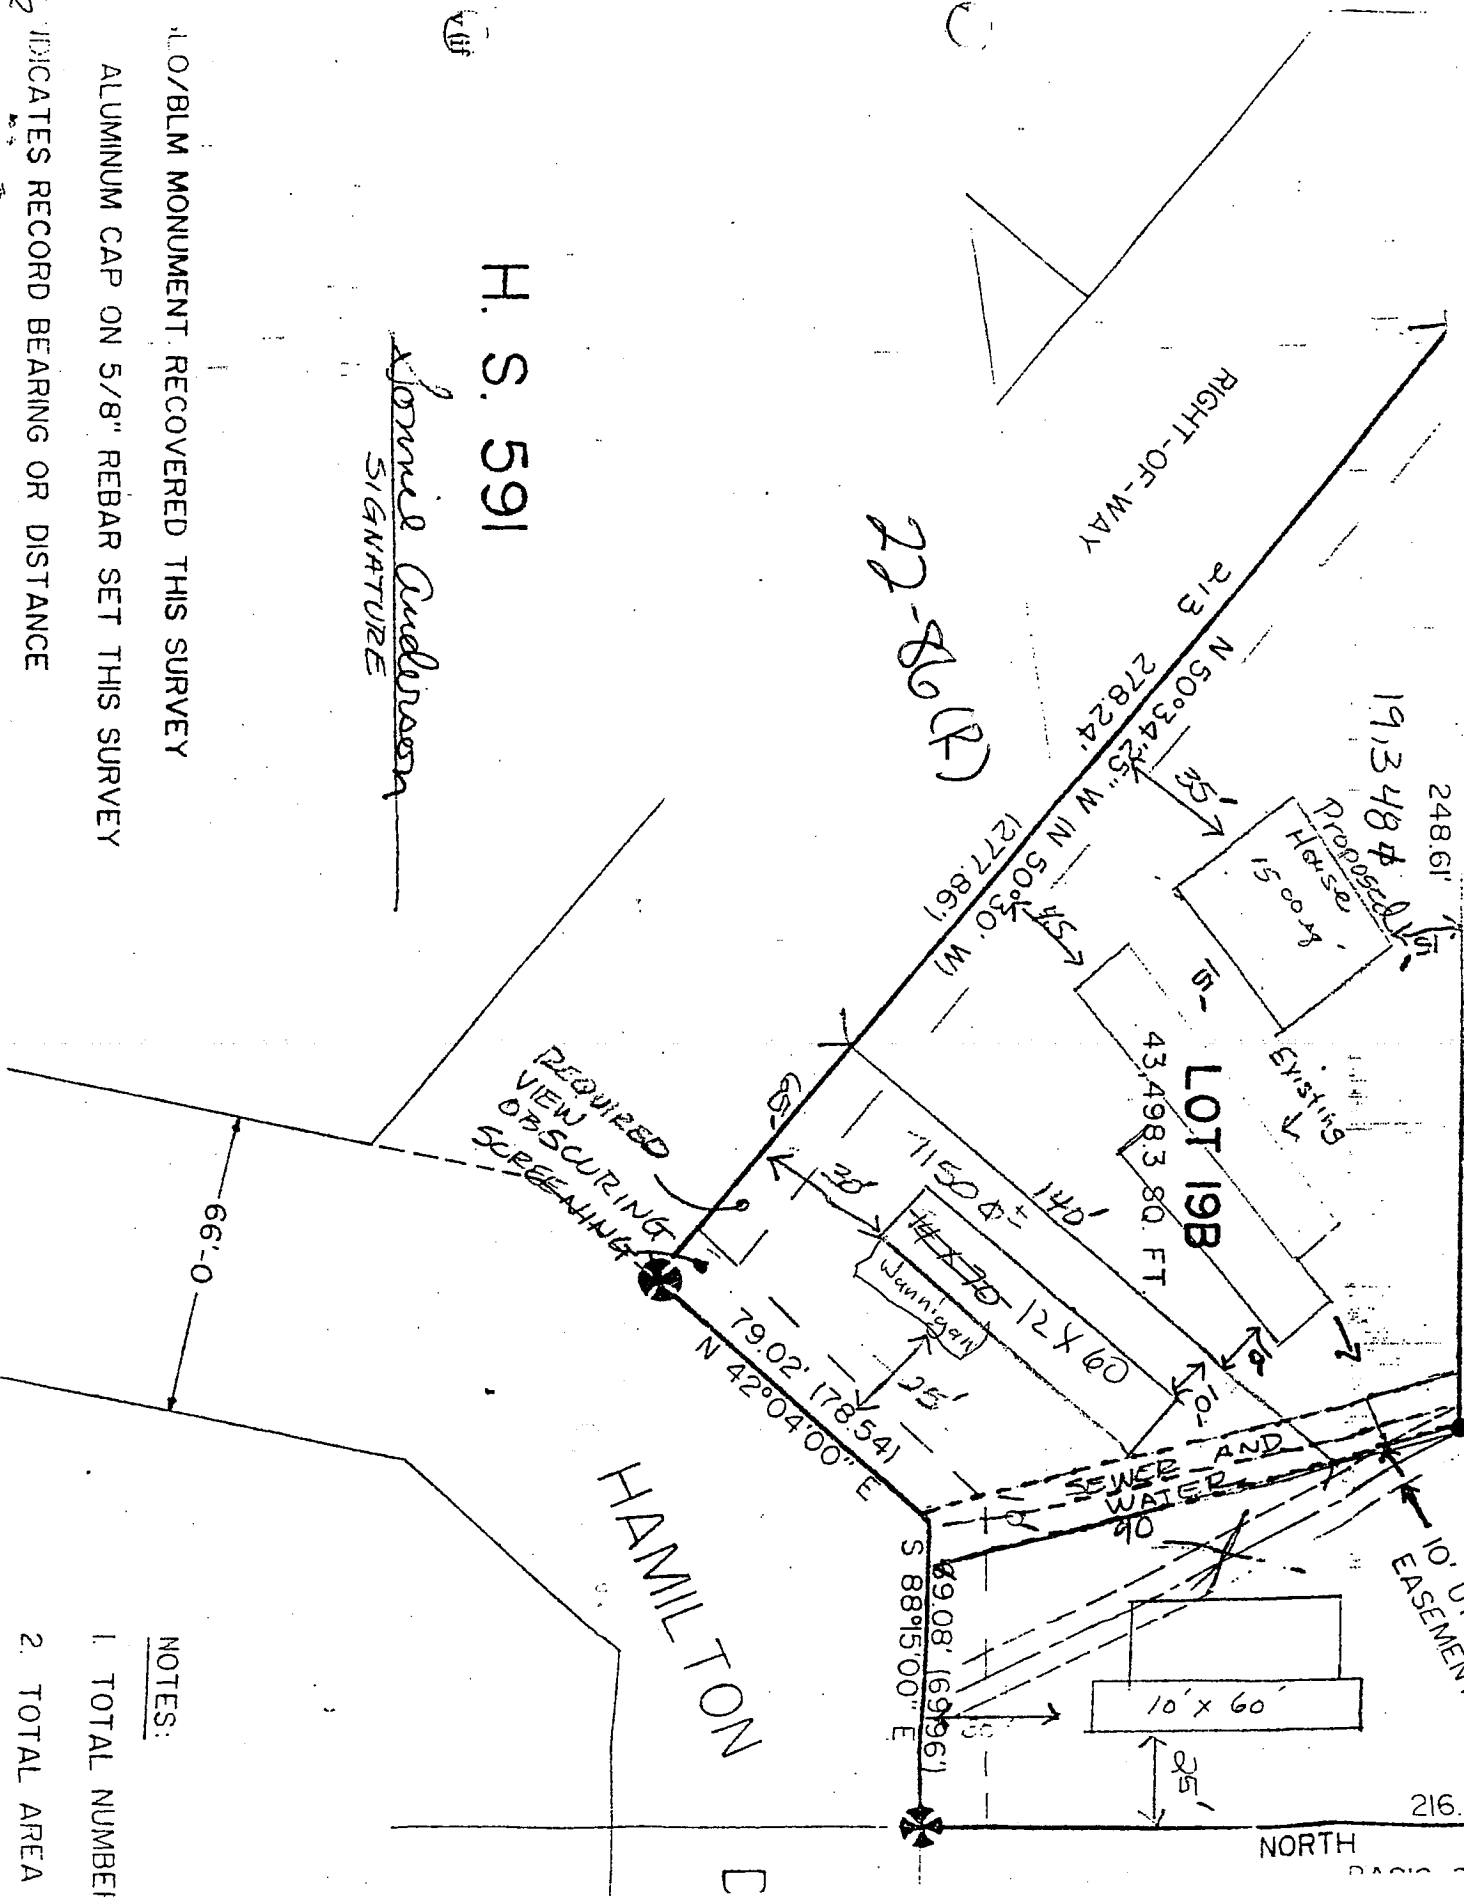

H. S. 591

James Anderson
SIGNATURE

AL/O/BLM MONUMENT RECOVERED THIS SURVEY

ALUMINUM CAP ON 5/8" REBAR SET THIS SURVEY

INDICATES RECORD BEARING OR DISTANCE

NOTES:

- 1. TOTAL NUMBER
- 2. TOTAL AREA S

216.3

NORTH

HAMILTON

LOT 19B

10' x 60'

S 88° 15' 00" E
49.08' (69.96')

N 42° 04' 00" E
79.02' (78.54')

43,498.380 FT

W IN 50° 30' W
127.86'

Proposed Horse
15' x 15'

Existing Horse

RIGHT-OF-WAY

22-86(R)

19,348.4

248.6'

10' U.I. EASEMENT

SEWER AND WATER

REQUIRED VIEW OF SCURRING SCREENING

66'-0"