

CITY OF CRAIG, ALASKA
BUILDING PERMIT APPLICATION

Applicant Information		Owner Information (if not also applicant)	
Name	Mike Hammel	Name	Mike McIntire
Mailing Address	PO 180	Mailing Address	PO 249 W. Hamilton
Street Address	600 Hamilton	Street Address	700
City, State, Zip	Craig AK 99921	City, State, Zip	Craig AK 99921
Telephone	907 401 0351	Telephone	401-0385

Property Description

Subdivision Name: Wind and Sea

Survey Number: _____ Tract Number: D Lot Number: 5 Block Number: _____

Army Corps of Engineers Permit Name and/or Number: _____

Building Activity Information (please check one)

Single Family Home Duplex Triplex Fourplex or greater
 Deck Porch Retaining Wall Addition
 Commercial Building Wannigan Garage Shed
 Mobile Home (Year and Make) _____
 Travel Trailer (Year and Make) _____
 Other (Please describe): CAR PORT

Height of Building at Roof Eve: 10' Closest setback to property line: 1'

Building Dimensions: 19x40 Area of building footprint: 760 SF

What use(s) do you propose for the building? Parking

Site Plan See Attached

Please complete on reverse side or attached sheet a site plan showing all proposed construction.

Owner's/Applicant's Statement

I acknowledge that I have read this application and state that the above information is correct. I agree to comply with all codes and ordinances of the City of Craig applicable to building and construction; and all land use regulations as pertaining to this permit. Any violation of land management regulations are the responsibility of the property owner. This permit becomes void upon completion of the approved work, or one year, whichever comes first. Work not documented in this application is not authorized by this building permit. I understand that this permit is revocable if work is not completed consistent with this applicant or if work does not comply with the requirements of the City of Craig Municipal Code. I agree to provide the City of Craig with an as-built survey of the lot in the event one is completed for this project.

Signature of Applicant: *Michael D Hammel* Date: _____
 Signature of Property Owner (if other than applicant): *Mike McIntire* Date: _____


Special Conditions of Approval.

The following conditions of approval are made a part of this permit as provided by section 18.06.001 B.6 of the Craig Land Development Code:

#1. No construction of walls or decks (above 30" from grade) within 10' of any property line.

Permission is hereby granted to perform the above work in compliance with any and all conditions listed above and in compliance with the Craig Land Development Code and all other ordinances of the City of Craig and the State of Alaska pertaining to the construction of buildings.


Signature of City Building Official: *Ben Flynn* Date: 10-10-18

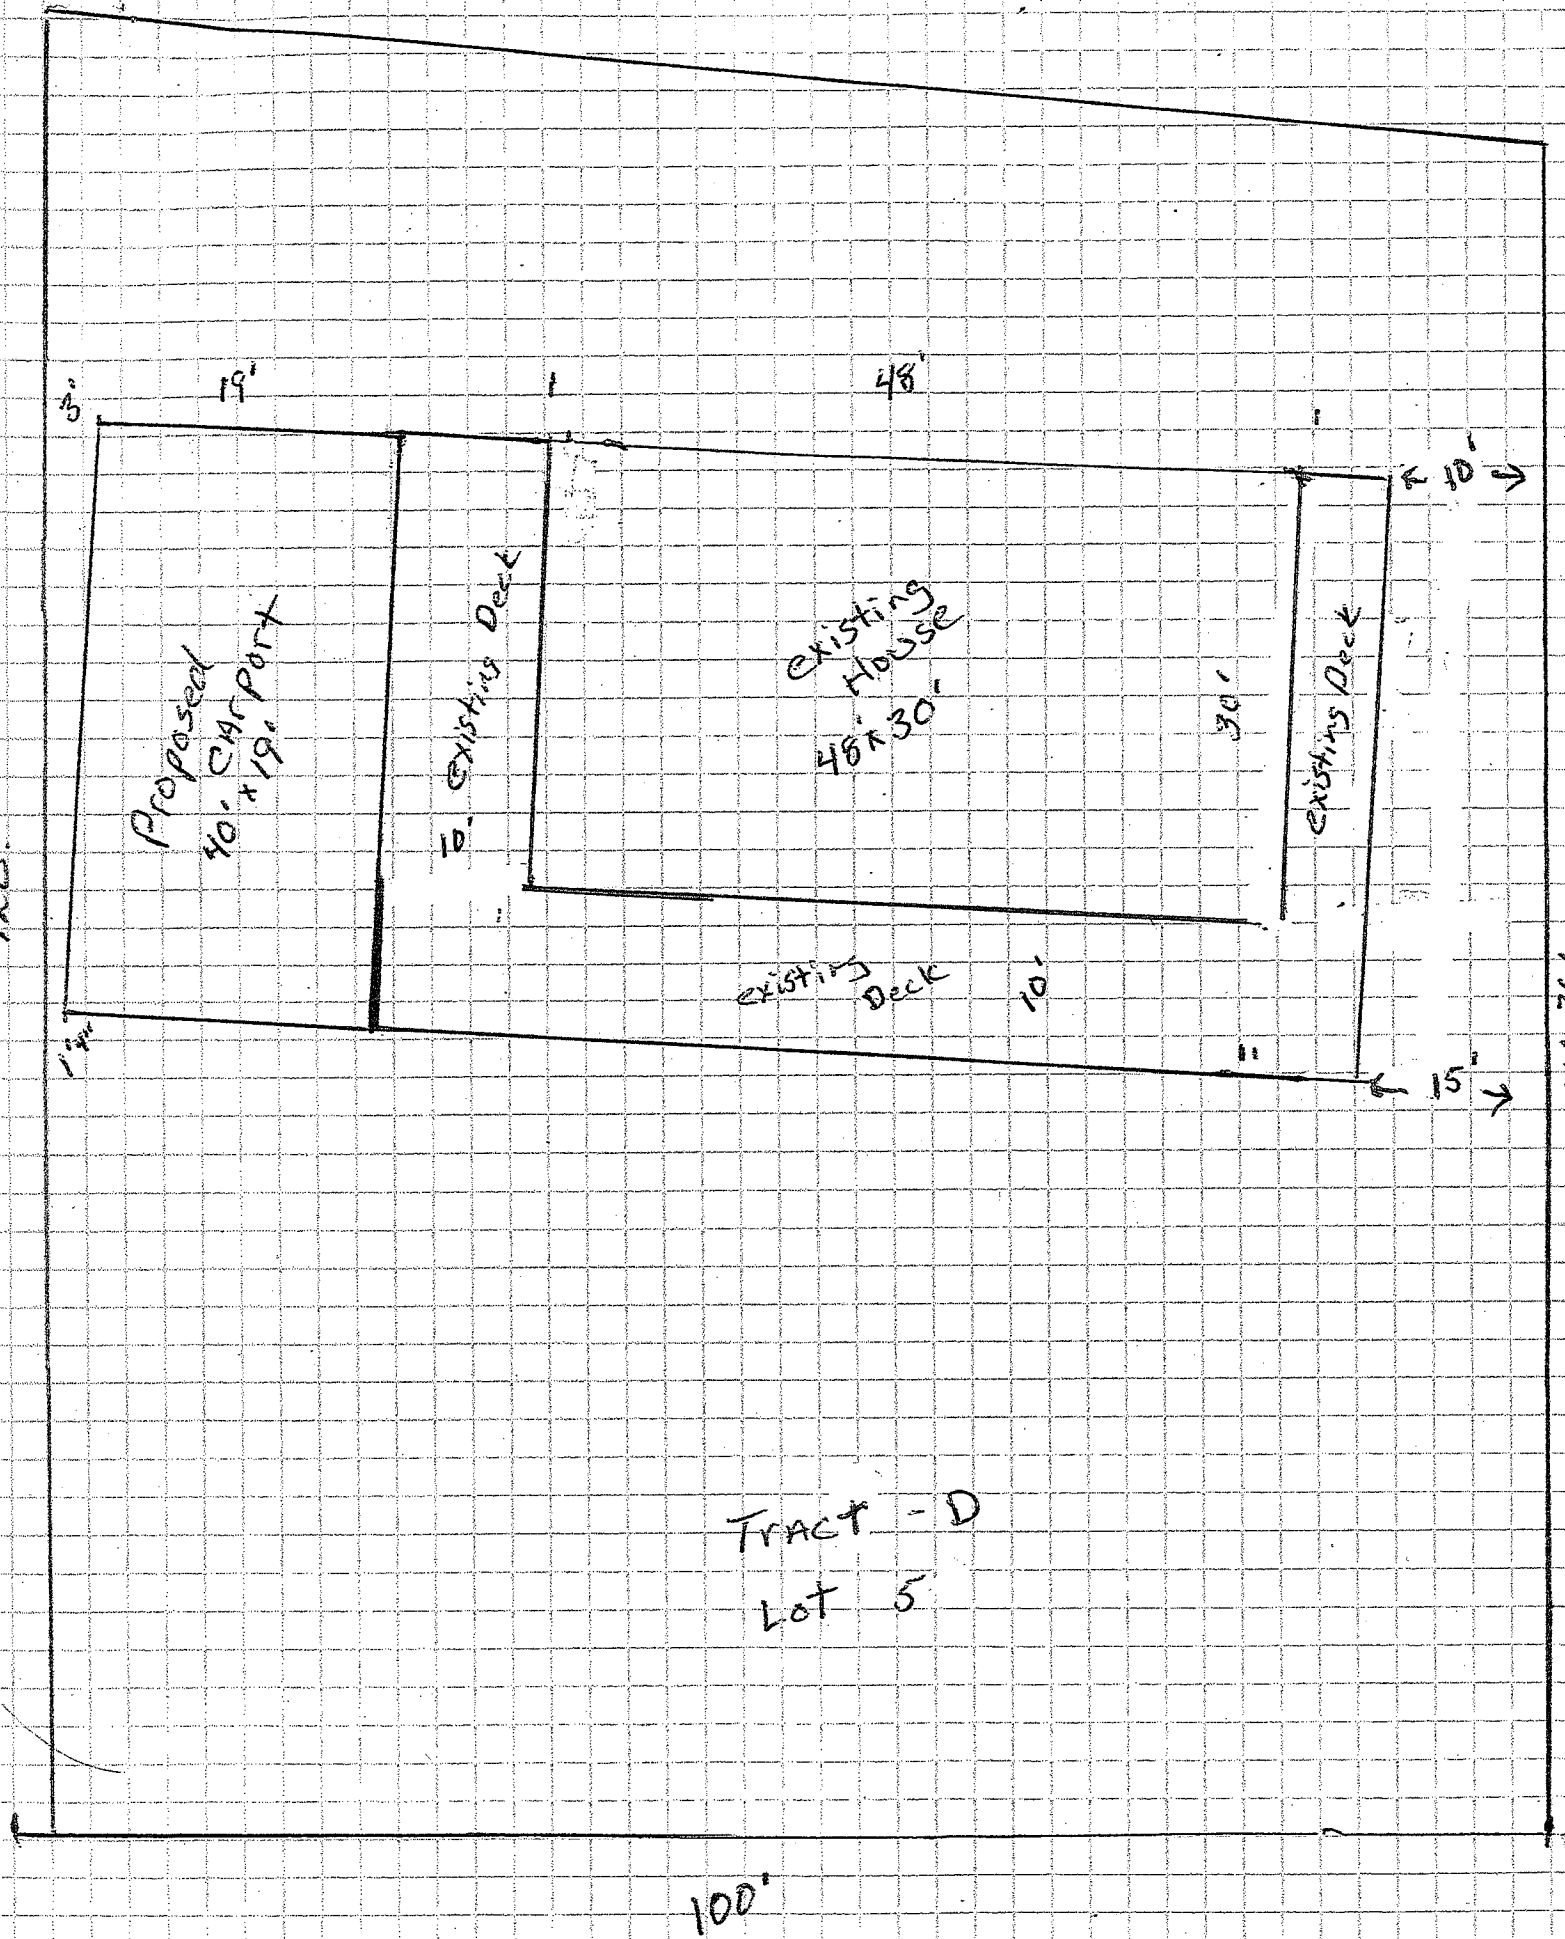

TRACT - D
LOT 5

100'

BP 12-18

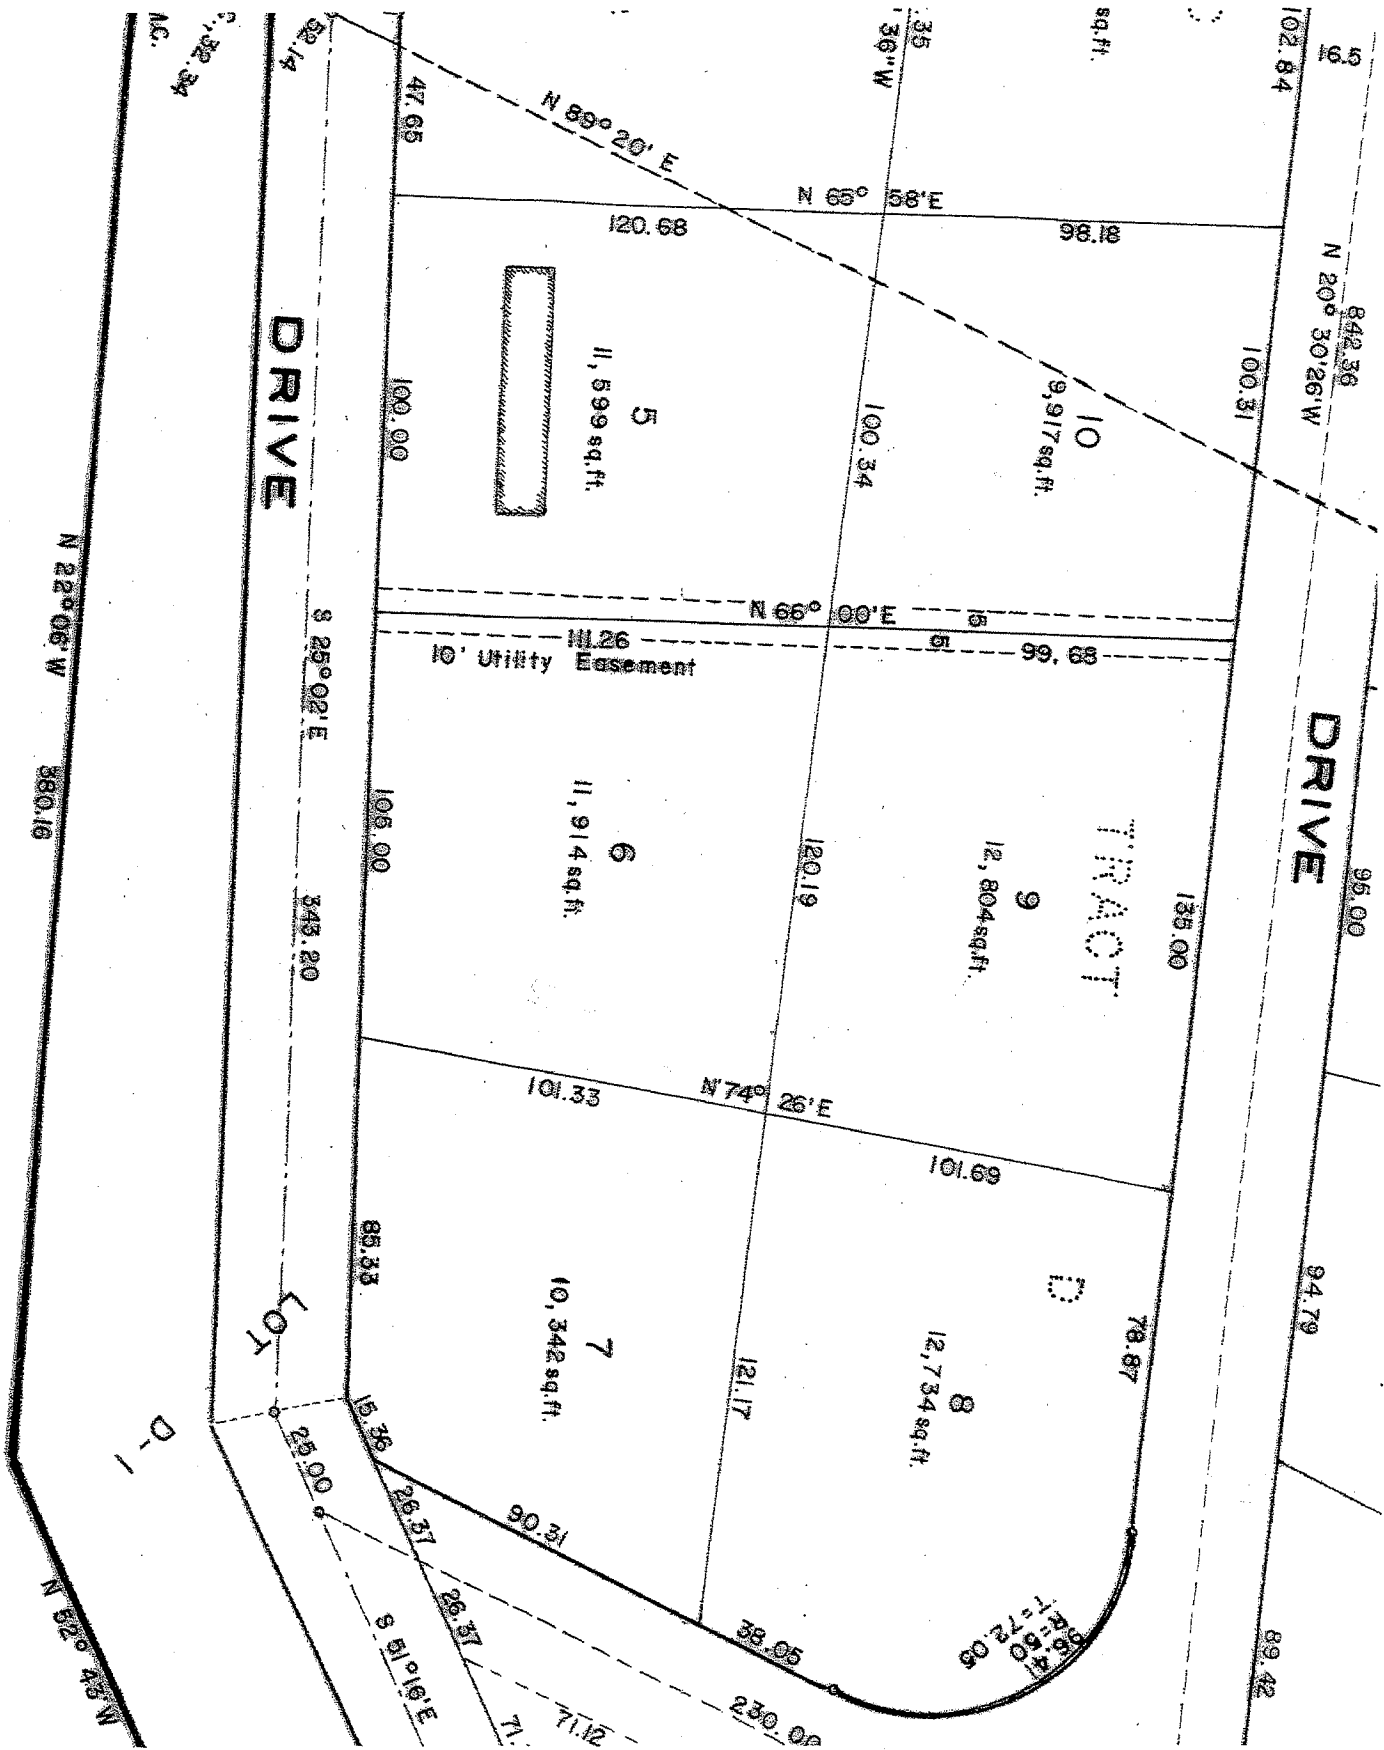

1"=20'

LOT 3A

LOT 3B

TRACT C

TRACT D

LOT 4

LOT 5

LOG BIN

SHED

HOUSE

GARAGE

CRAIG BIBLE CHURCH

$\Delta = 9'30''59''$
 $R = 800$
 $L = 132.88'$

BP 12-18

FILL AREA

PARKING AREA

PARKING AREA

FIELD LOCATE

POWERLINES

4" ABS SEWER

105.00'

8" DI SEWER

8" DI WATER

PARKING AREA

LOT D-1

INV 19.81

12" CMP
71.01'

INV 19.37

INV 18.83

12" CMP

WM (R) 68.34'

INV 17.86

INV 18.98

INV 18.60

RIM ELEV = 19.33
8" INLET INV SOUTH ELEV = 15.63
8" OUTLET INVERT NORTH ELEV = 15.58

ROW (TYP)
47.65'

STUMP

EDGE OF ROAD (TYP)

18" CMP

INV 18.61

INV 19.09

18" CMP

100.00'

INV 18.29

CS

PH

WEST

(R) S 15°29'00" E

(C) S 15°31'01" E

481.80'

483.17'

HAMILTON

(R) S 25°02'00" E

(R) S 25°02'00" E

(C) S 25°02'00" E

343.20'

342.71'

32°00' E

485.10'

MHW LINE OF RECORD

PARKING AREA

AREA

35.07'

N 89°20'00" E

18" CMP

WV

FH

PROJECT TBM
BOLT NEXT TO "N" IN OPEN
TOP FLANGE ELEV = 22.50

380.16'

N 22°06'00" W

PIPE

46

15+29 PT

N 65°58' E

DRIVEWAY

N 66°00' E

