

27-11

# CITY OF CRAIG, ALASKA BUILDING PERMIT APPLICATION

Applicant Information		Owner Information (if not also applicant)	
Name		Name	Jon Bolling
Mailing Address		Mailing Address	PO Box 509
Street Address		Street Address	510 FIRST ST
City, State, Zip		City, State, Zip	Craig, AK 99921
Telephone		Telephone	826-3061

**Property Description**

Subdivision Name \_\_\_\_\_

Survey Number: 1430 Tract Number: \_\_\_\_\_ Lot Number: 4B Block Number: 16

Army Corps of Engineers Permit Name and/or Number: \_\_\_\_\_

**Building Activity Information (please check one)**

<input type="checkbox"/> Single Family Home	<input type="checkbox"/> Duplex	<input type="checkbox"/> Triplex	<input type="checkbox"/> Fourplex or greater
<input type="checkbox"/> Deck	<input type="checkbox"/> Porch	<input type="checkbox"/> Retaining Wall	<input type="checkbox"/> Addition
<input type="checkbox"/> Commercial Building	<input type="checkbox"/> Wannigan	<input type="checkbox"/> Garage	<input type="checkbox"/> Shed
<input type="checkbox"/> Mobile Home (Year and Make) _____			
<input type="checkbox"/> Travel Trailer (Year and Make) _____			
<input type="checkbox"/> Other (Please describe): <b>Paving Driveway, approx 3,000 square feet</b>			

Height of Building at Roof Eve: \_\_\_\_\_ Closest setback to property line: \_\_\_\_\_

Building Dimensions: \_\_\_\_\_ Area of building footprint: \_\_\_\_\_

What use(s) do you propose for the building? \_\_\_\_\_

**Site Plan**

Please complete on reverse side or attached sheet a site plan showing all proposed construction.

**Owner's/Applicant's Statement**

I acknowledge that I have read this application and state that the above information is correct. I agree to comply with all codes and ordinances of the City of Craig applicable to building and construction, and all land use regulations as pertaining to this permit. Any violation of land management regulations are the responsibility of the property owner. This permit becomes void upon completion of the approved work, or one year, whichever comes first. Work not documented in this application is not authorized by this building permit. I understand that this permit is revocable if work is not completed consistent with this applicant or if work does not comply with the requirements of the City of Craig Municipal Code. I agree to provide the City of Craig with an as-built survey of the lot in the event one is completed for this project.

Signature of Applicant \_\_\_\_\_ Date \_\_\_\_\_

Signature of Property Owner (if other than applicant) \_\_\_\_\_ Date 10/5/2011

**Special Conditions of Approval.**

The following conditions of approval are made a part of this permit as provided by section 18.06.001B.6 of the Craig Land Development Code:

1. Sidework/Paving only. No building construction or modification without submission of a complete site plan.

Permission is hereby granted to perform the above work in compliance with any and all conditions listed above and in compliance with the Craig Land Development Code and all other ordinances of the City of Craig and the State of Alaska pertaining to the construction of buildings.

Signature of City Building Official \_\_\_\_\_ Date \_\_\_\_\_

BP27-11

~~7807~~



FIRST STREET

LOT 5-A

Found Rebar/Alcap (typ)

Add Pavement

S83°45'00"E 105.00'

Pave Driveway  
Gravel Driveway

N06°15'00"E 85.00'

18.5' 5.0' 9.7' 24.5'

Water Meter

wood deck

2-Story Wood Frame House

LOT 4-B

Conc. Pad

24.0'

30'

24.0'

28.0'

S06°15'00"W 85.00'

25.3'

47.42'

19.3'

5.0'

12.8'

24.0'

NEW DECK

24'

8.0'

25.2'

95.00'

N83°45'03"W

16

10.00'

Fence

LOT 3-B

BLOCK

LOT 2-A


AS-BUILT SURVEY OF:

LOT 4-B, BLOCK 16, USS 1430, CRAIG, AK.

I hereby certify that the above described property has been surveyed by me and that the improvements situated thereon are within the property lines and do not encroach or overlap on the adjacent property lines and that there are no roadways, transmission lines or other visible easements on said property, except as indicated hereon.

Date: 6/26/98 Scale: 1" = 20' Drawn by: CLT

Craig L. Templin - Whale Pass PO Box WWP - Ketchikan, AK. 99950

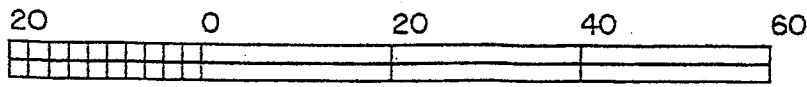

GRAPHIC SCALE - FEET

