

BP 13-10

CITY OF CRAIG, ALASKA BUILDING PERMIT APPLICATION

Applicant Information

Name Monetta Burnham
Mailing Address PO Box 984
Street Address 914 Chaan Court
City, State, Zip Craig AK 99921
Telephone 401-0920

Owner Information (if not also applicant)

Name Shaan-Seat Line
Mailing Address PO Box 690
Street Address 501 Main St
City, State, Zip Craig AK 99921
Telephone 407-826-3251

Property Description

Subdivision Name Shaan Seat Trailer Court Sp 914
Survey Number: _____ Tract Number: _____ Lot Number: _____ Block Number: _____
Army Corps of Engineers Permit Name and/or Number: _____

Building Activity Information (please check one)

- Single Family Home
- Deck
- Commercial Building
- Mobile Home (Year and Make) 1979 Kentwood
- Travel Trailer (Year and Make)
- Other (Please describe): _____
- Duplex
- Porch
- Wannigan
- Triplex
- Retaining Wall
- Garage
- Fourplex or greater
- Addition
- Shed

Height of Building at Roof Eve: _____ Closest setback to property line: _____
Building Dimensions: 14x70 Area of building footprint: _____
What use(s) do you propose for the building? to live in

Site Plan

Please complete on reverse side or attached sheet a site plan showing all proposed construction.

Owner's/Applicant's Statement

I acknowledge that I have read this application and state that the above information is correct. I agree to comply with all codes and ordinances of the City of Craig applicable to building and construction, and all land use regulations as pertaining to this permit. Any violation of land management regulations are the responsibility of the property owner. This permit becomes void upon completion of the approved work, or one year, whichever comes first. Work not documented in this application is not authorized by this building permit. I understand that this permit is revocable if work is not completed consistent with this applicant or if work does not comply with the requirements of the City of Craig Municipal Code. I agree to provide the City of Craig with an as-built survey of the lot in the event one is completed for this project.

Signature of Applicant Monetta Burnham Date 6/17/10
Signature of Property Owner (if other than applicant) Robert Kahl Date 6/17/10


Special Conditions of Approval.

The following conditions of approval are made a part of this permit as provided by section 18.06.001B.6 of the Craig Land Development Code:
#1. Must modify site plan to show wannigan and entry dimensions prior to construction.
#2. No structure may be placed within 10' of property/space line.


Permission is hereby granted to perform the above work in compliance with any and all conditions listed above and in compliance with the Craig Land Development Code and all other ordinances of the City of Craig and the State of Alaska pertaining to the construction of buildings.

Signature of City Building Official _____ Date _____

SHAAAN SEET TRAILER COURT

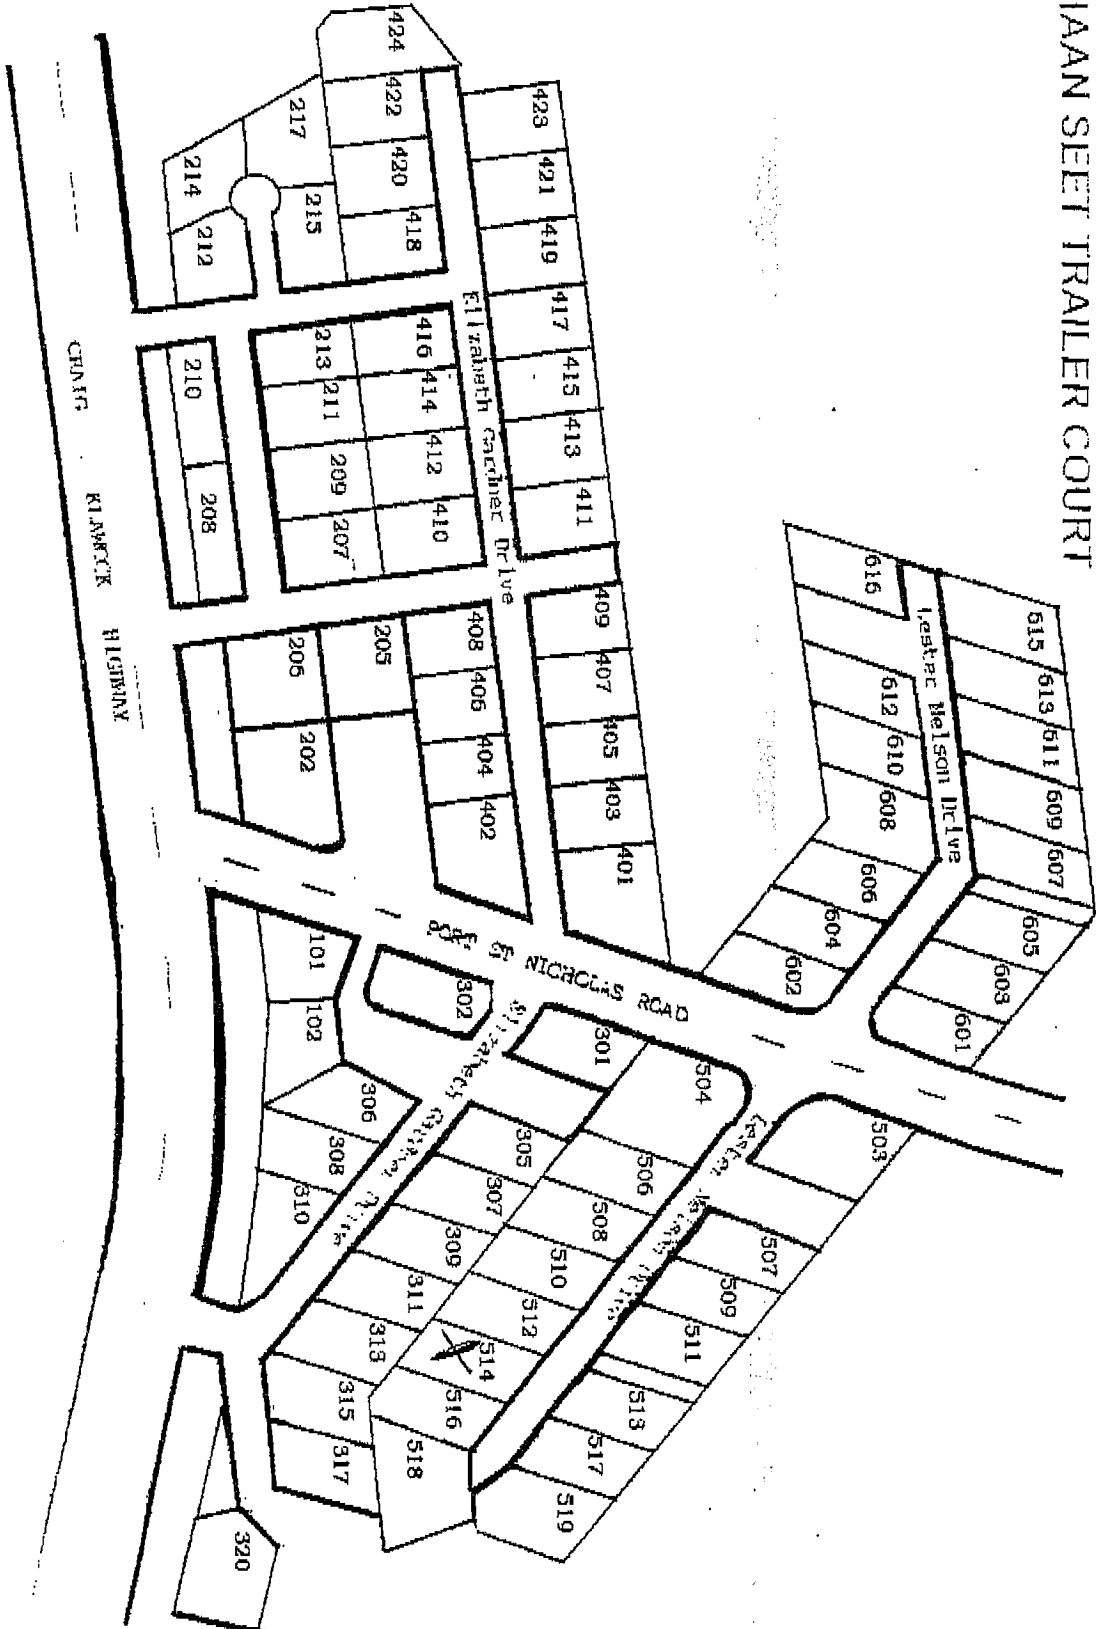

BP 13-10

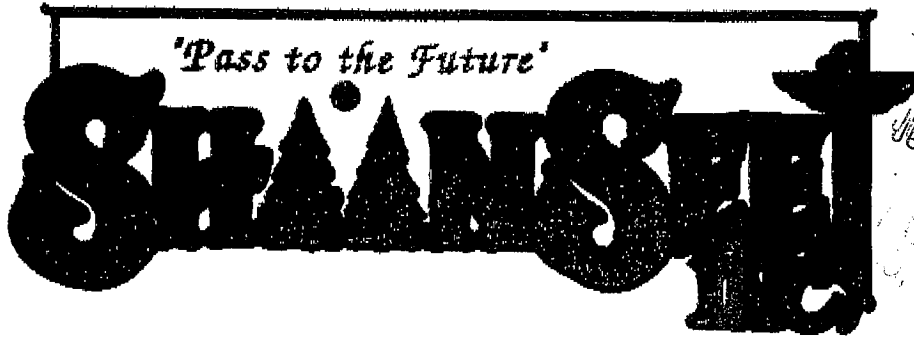

RECEIVED
 JUN 17 2010
 CITY OF CRAIG
 ALASKA

FACSIMILE TRANSMITTAL SHEET

TO:	FROM: Shaan-Seet, Inc.
COMPANY: City of Craig	DATE: 06/15/10
FAX NUMBER: 826-3278	TOTAL NO. OF PAGES INCLUDING COVER: 2
CG:	SENDER'S PHONE NUMBER: 907-826-3251
	CONTACT PERSON/SENT BY: Rebekah Schafer

URGENT
 FOR REVIEW
 PLEASE COMMENT
 PLEASE RESPOND

Location for Micki Burnham's Trailer, number 514

SITE PLAN

Show the items from the checklist below in the drawing grid. The drawing must be legible and accurate.

- | | |
|--|-----------------------------------|
| <hr/> Lot lines and dimensions | <hr/> Water lines |
| <hr/> Distances from all structures to lot lines | <hr/> Sewer lines |
| <hr/> Proposed structures with dimensions | <hr/> Electric lines and poles |
| <hr/> All easements, streets, alleys, sidewalks | <hr/> Driveways |
| <hr/> Existing structures and their dimensions | <hr/> North Arrow |
| <hr/> Parking spaces | <hr/> Other pertinent information |

14 x 70 M.H.

PORCH & STAIRS
TO BE ADDED

LAN.
TO BE ADDED

