

CITY OF CRAIG, ALASKA
BUILDING PERMIT APPLICATION

Applicant Information		Owner Information (if not also applicant)	
Name	<i>Lewis Bird</i>	Name	<i>Church of Jesus Christ of Latter-day Saints</i>
Mailing Address	<i>P.O. Box 512</i>	Mailing Address	
Street Address	<i>6320 C St.</i>	Street Address	<i>50 E N Temple</i>
City, State, Zip	<i>Klawock, AK 99925</i>	City, State, Zip	<i>Salt Lake City, UT</i>
Telephone	<i>209-521-7843</i>	Telephone	<i>94150</i>

Property Description

Subdivision Name *Windansea Subd.*

Survey Number: *USS 2611* Tract Number: _____ Lot Number: *30A* Block Number: _____

Army Corps of Engineers Permit Name and/or Number: _____

Building Activity Information (please check one)

<input type="checkbox"/> Single Family Home	<input type="checkbox"/> Duplex	<input type="checkbox"/> Triplex	<input type="checkbox"/> Fourplex or greater
<input type="checkbox"/> Deck	<input type="checkbox"/> Porch	<input type="checkbox"/> Retaining Wall	<input type="checkbox"/> Addition
<input type="checkbox"/> Commercial Building	<input type="checkbox"/> Wannigan	<input type="checkbox"/> Garage	<input type="checkbox"/> Shed
<input type="checkbox"/> Mobile Home (Year and Make) _____			
<input type="checkbox"/> Travel Trailer (Year and Make) _____			
<input checked="" type="checkbox"/> Other (Please describe): <i>pat Building 12' by 18' Building</i>			

Height of Building at Roof Eve: *14'* Closest setback to property line: *50'*

Building Dimensions: *12' by 18'* Area of building footprint: *370'*

What use(s) do you propose for the building? *CLASSROOM SPACE*

Site Plan

Please complete on reverse side or attached sheet a site plan showing all proposed construction.

Owner's/Applicant's Statement

I acknowledge that I have read this application and state that the above information is correct. I agree to comply with all codes and ordinances of the City of Craig applicable to building and construction, and all land use regulations as pertaining to this permit. Any violation of land management regulations are the responsibility of the property owner. This permit becomes void upon completion of the approved work, or one year, whichever comes first. Work not documented in this application is not authorized by this building permit. I understand that this permit is revocable if work is not completed consistent with this applicant or if work does not comply with the requirements of the City of Craig Municipal Code. I agree to provide the City of Craig with an as-built survey of the lot in the event one is completed for this project.

Lewis R. Bird *8/17/09* _____
 Signature of Applicant Date Signature of Property Owner (if other than applicant) Date

Special Conditions of Approval.

The following conditions of approval are made a part of this permit as provided by section 18.06.001B.6 of the Craig Land Development Code:


#1. No construction within 10' of property line.

#2. No occupancy or use without fire marshal approval or notice that review is not required.

Permission is hereby granted to perform the above work in compliance with any and all conditions listed above and in compliance with the Craig Land Development Code and all other ordinances of the City of Craig and the State of Alaska pertaining to the construction of buildings.

 Signature of City Building Official Date *8-17-09*

BP 23-09

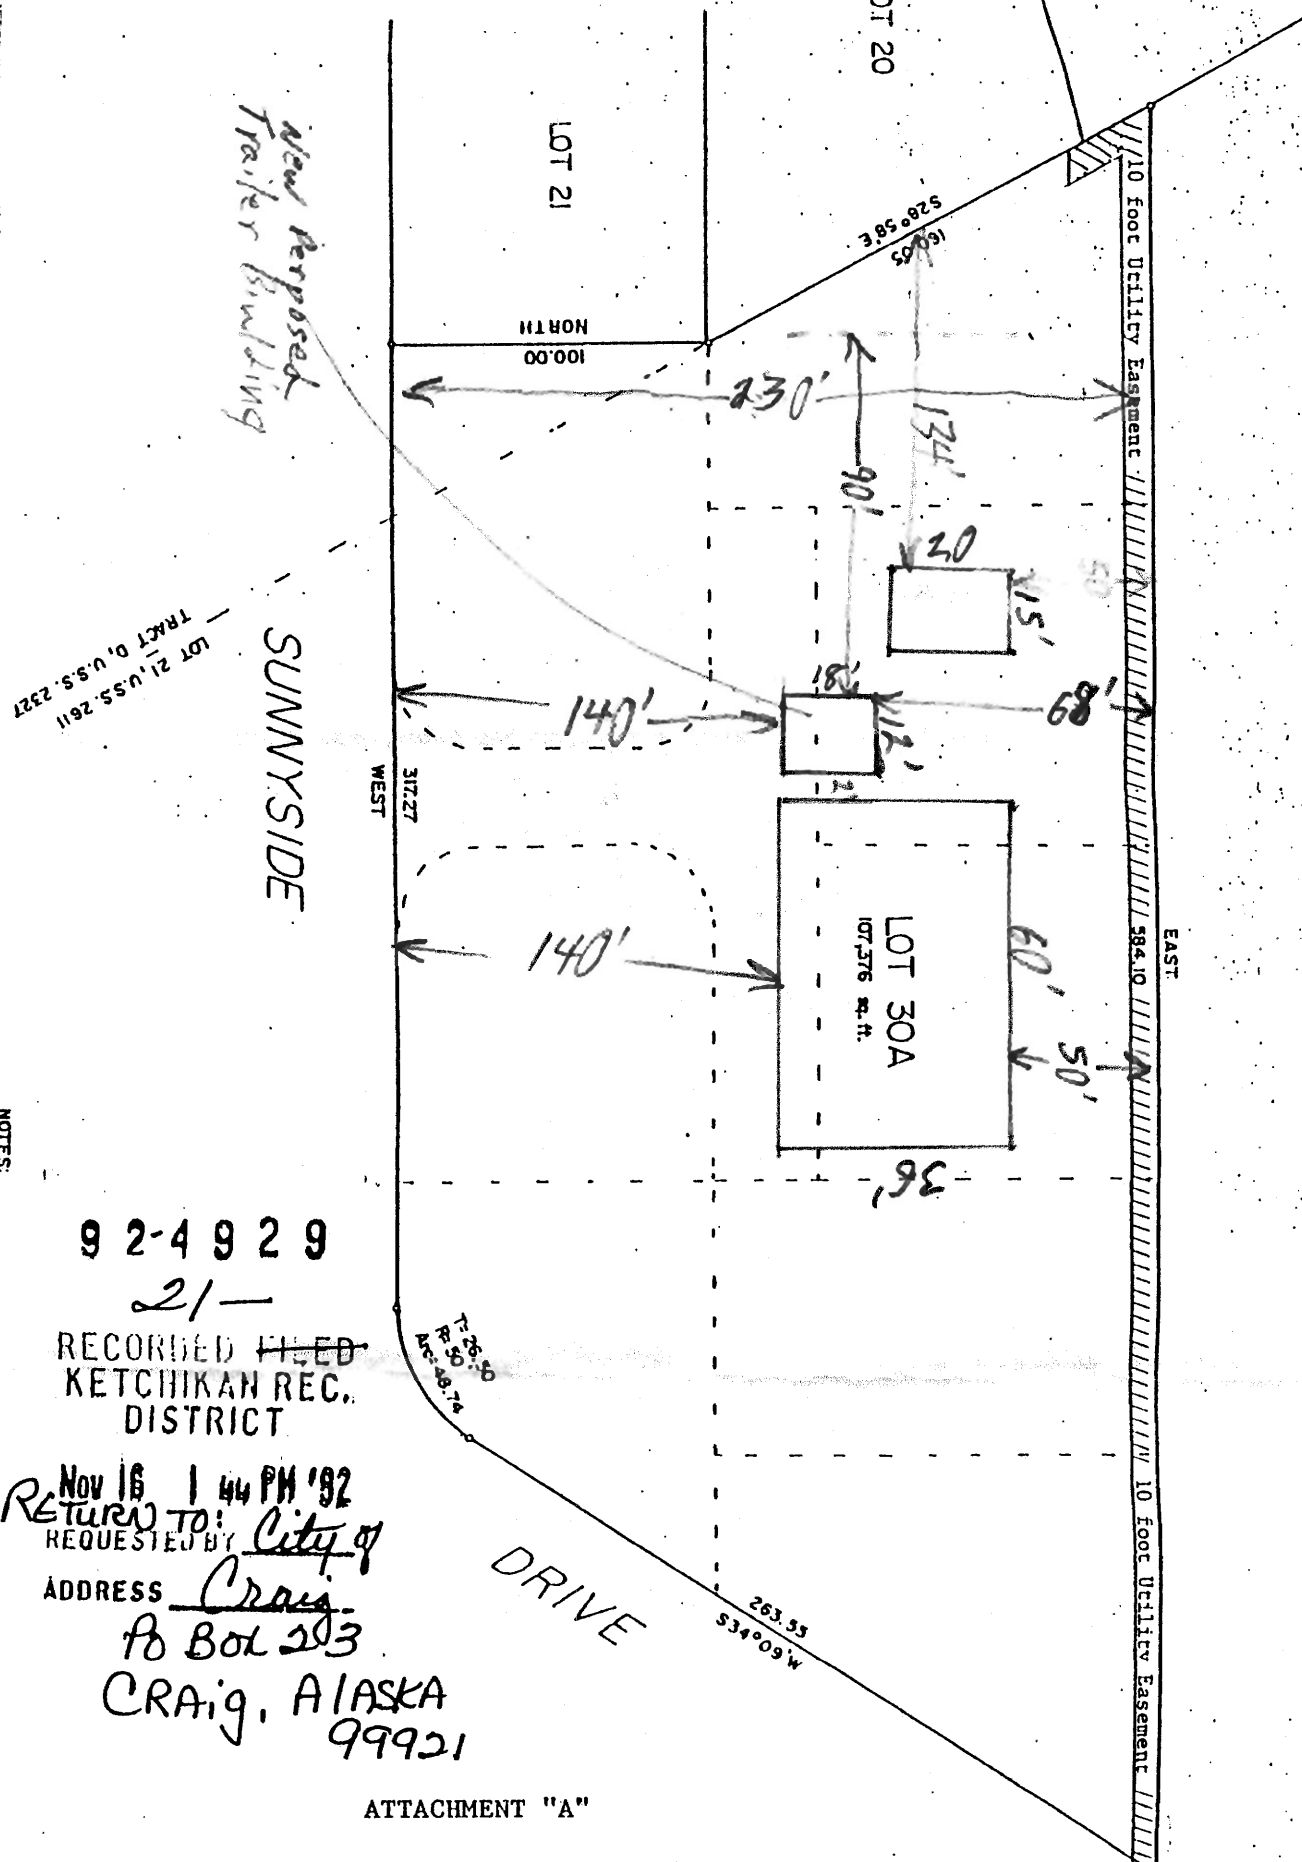

New Proposed Trailer Building

LOT 21, U.S.S. 2611 TRACT 0, U.S.S. 2327

SUNNYSIDE

WEST

EAST

DRIVE

NOTES:

9 2 - 4 9 2 9

21-

RECORDED FILED
KETCHIKAN REC.
DISTRICT

Nov 16 1 44 PM '92
RETURN TO: City of

REQUESTED BY
ADDRESS Craig
PO Box 203
CRAIG, ALASKA
99921

ATTACHMENT "A"



State of Alaska

Department of Public Safety

Division of Fire and Life Safety

BP-23-09

RECEIVED

Sean Parnell, Governor
Joseph A Masters, Commissioner

SEP 22 2009

September 17, 2009

CITY OF CRAIG
CRAIG, ALASKA

Lewis Bird
Church of JC/LDS Chapel
P. O. Box 512
Klawock, AK 99925

SUBJECT: Church of JC of LDS - Classroom 1 - Craig -
Renovation / Remodel
CITY: Craig
PLAN REVIEW: 2009 June 11 91
OCCUPANCY: E
2006 INTERNATIONAL BUILDING AND FIRE CODE

Dear Lewis Bird:

Plans for the Renovation / Remodel have been reviewed by this office for conformity with the State Fire Safety Regulations and are hereby approved. Enclosed is a certificate of approval that must be posted on the premises until the project has been completed according to the approved plans and all regulations have been adhered to.

Approval of submitted plans is not approval of omissions or oversights by this office or noncompliance with any applicable regulations of the Municipal Government.

It must be understood that the inclusion of and compliance with State Fire Safety Regulations does not preclude the necessity of compliance with the requirements of local codes and ordinances.

If we can be of further assistance in this matter, please feel free to contact us at the address below.

Sincerely,

Robert Plumb
Deputy Fire Marshal
Life Safety Inspection Bureau

cc: Supervisor
Craig Building and Fire Official
Enclosure: Approval Certificate