
26-09

CITY OF CRAIG, ALASKA			
BUILDING PERMIT APPLICATION			
Applicant Information		Owner Information	(if not also applicant)
Name South SNOO	KS FIR , Pres,	Name Todd	Ten
Mailing Address るると / (	68	Mailing Address $oldsymbol{\mathcal{H}}$	8× 347
Street Address 407 Spin	CP SY	Street Address	
City, State, Zip (こん)			
Telephone 826-739		Telephone 7	55-2813
Property Description			
Subdivision Name Lot	8, BLK8, 0	USS1430 ,	Craik, Alaska
Survey Number:	Tract Number:	Lot Number:	Block Number:
Army Corps of Engineers Permi			
<b>Building Activity Information</b>			
☐ Single Family Home	□ Duplex	☐ Triplex	☐ Fourplex or greater
□ Deck	□ Porch	☐ Retaining Wall	☐ Addition
☐ Commercial Building	☐ Wannigan	☐ Garage	<b>Ø</b> Shed
☐ Mobile Home (Year and Mal			
☐ Travel Trailer (Year and Ma	ke <u>)</u>		
☐ Other (Please describe):			
Height of Building at Roof Eve:		Closest setback to pr	
Building Dimensions: 8 × /৫	<u></u>	Area of buildi	ng footprint: Less Than 120
What use(s) do you propose for	the building?		
Site Plan		-	-
☐ Please complete on reverse	side or attached she	et a site plan showing	all proposed construction.
			3
	application and state that e City of Craig applicable rmit. Any violation of land becomes void upon compocumented in this applicated becable if work is not compocity of Craig Municipal with an as-built survey of	t the above information is to building and construct dimanagement regulation pletion of the approved wation is not authorized by bleted consistent with this Code.	s correct. I agree to comply tion, and all land use as are the responsibility rork, or one year, this building permit. applicant or if work does not s completed for this project.
I acknowledge that I have read this with all codes and ordinances of the regulations as pertaining to this per of the property owner. This permit whichever comes first. Work not do I understand that this permit is revo	application and state that e City of Craig applicable rmit. Any violation of land becomes void upon compocumented in this applicate cable if work is not compectity of Craig Municipal with an as-built survey of Date	t the above information is to building and construct dimanagement regulation pletion of the approved wation is not authorized by bleted consistent with this Code.	s correct. I agree to comply tion, and all land use as are the responsibility rork, or one year, this building permit. applicant or if work does not
I acknowledge that I have read this with all codes and ordinances of the regulations as pertaining to this per of the property owner. This permit whichever comes first. Work not do I understand that this permit is revo comply with the requirements of the I agree to provide the City of Craig Signature of Applicant  Special Conditions of Approved The following conditions of approved Craig Land Development Code:	application and state that e City of Craig applicable rmit. Any violation of land becomes void upon compocumented in this applicate cable if work is not compocable if work is not compocable.	t the above information is to building and construct dimanagement regulation pletion of the approved wation is not authorized by oleted consistent with this Code.  I the lot in the event one is Signature of Property	s correct. I agree to comply tion, and all land use as are the responsibility rork, or one year, this building permit. applicant or if work does not s completed for this project.  y Owner (if other than applicant) Date ction 18.06.001B.6 of the
I acknowledge that I have read this with all codes and ordinances of the regulations as pertaining to this per of the property owner. This permit whichever comes first. Work not do I understand that this permit is revo comply with the requirements of the I agree to provide the City of Craig Signature of Applicant  Special Conditions of Approvements of the following conditions of approvements of approvements of the complex conditions of approvements and Development Code:	application and state that e City of Craig applicable rmit. Any violation of land becomes void upon compocumented in this application of cable if work is not compocity of Craig Municipal with an as-built survey of Date al.	t the above information is to building and construct management regulation pletion of the approved wation is not authorized by bleted consistent with this Code.  The lot in the event one is Signature of Property permit as provided by see the lot in the	s correct. I agree to comply tion, and all land use as are the responsibility rork, or one year, this building permit. applicant or if work does not s completed for this project.  y Owner (if other than applicant) Date
I acknowledge that I have read this with all codes and ordinances of the regulations as pertaining to this per of the property owner. This permit whichever comes first. Work not do I understand that this permit is revo comply with the requirements of the I agree to provide the City of Craig Signature of Applicant  Special Conditions of Approved The following conditions of approved Craig Land Development Code:	application and state that e City of Craig applicable rmit. Any violation of land becomes void upon compocumented in this application of cable if work is not compocity of Craig Municipal with an as-built survey of Date al.	t the above information is to building and construct management regulation pletion of the approved wation is not authorized by bleted consistent with this Code.  The lot in the event one is Signature of Property permit as provided by see the lot in the	s correct. I agree to comply tion, and all land use as are the responsibility rork, or one year, this building permit. applicant or if work does not s completed for this project.  y Owner (if other than applicant) Date ction 18.06.001B.6 of the
I acknowledge that I have read this with all codes and ordinances of the regulations as pertaining to this per of the property owner. This permit whichever comes first. Work not do I understand that this permit is revo comply with the requirements of the I agree to provide the City of Craig Signature of Applicant  Special Conditions of Approvements of the following conditions of approvements of approvements of the complex conditions of approvements and Development Code:	application and state that e City of Craig applicable rmit. Any violation of land becomes void upon compocumented in this application of cable if work is not compocity of Craig Municipal with an as-built survey of Date al.	t the above information is to building and construct management regulation pletion of the approved wation is not authorized by bleted consistent with this Code.  The lot in the event one is Signature of Property permit as provided by see the lot in the	s correct. I agree to comply tion, and all land use as are the responsibility rork, or one year, this building permit. applicant or if work does not s completed for this project.  y Owner (if other than applicant) Date ction 18.06.001B.6 of the
I acknowledge that I have read this with all codes and ordinances of the regulations as pertaining to this per of the property owner. This permit whichever comes first. Work not do I understand that this permit is revo comply with the requirements of the I agree to provide the City of Craig Signature of Applicant  Special Conditions of Approvements of the following conditions of approvements of approvements of the complex conditions of approvements and Development Code:	application and state that e City of Craig applicable rmit. Any violation of land becomes void upon compocumented in this application of cable if work is not compocity of Craig Municipal with an as-built survey of Date al.	t the above information is to building and construct management regulation pletion of the approved wation is not authorized by bleted consistent with this Code.  The lot in the event one is Signature of Property permit as provided by see the lot in the	s correct. I agree to comply tion, and all land use as are the responsibility rork, or one year, this building permit. applicant or if work does not s completed for this project.  y Owner (if other than applicant) Date ction 18.06.001B.6 of the
I acknowledge that I have read this with all codes and ordinances of the regulations as pertaining to this per of the property owner. This permit whichever comes first. Work not do I understand that this permit is revo comply with the requirements of the I agree to provide the City of Craig Signature of Applicant  Special Conditions of Approvements of Approvements and Development Code:  # Discussed with the following conditions of approvements are considered to the city of Craig Land Development Code:  # Discussed with the following conditions of approvements are considered to the city of Craig Land Development Code:  # Discussed with the following conditions of approvements are considered to the city of Craig Land Development Code:  # Discussed with the following conditions of approvements are considered to the city of Craig Land Development Code:  # Discussed with the following conditions of approvements are considered to the city of Craig Land Development Code:  # Discussed with the city of Craig Land Development Code:  # Discussed with the city of Craig Land Development Code:  # Discussed with the city of Craig Land Development Code:  # Discussed with the city of Craig Land Development Code:  # Discussed with the city of Craig Land Development Code:  # Discussed with the city of Craig Land Development Code:  # Discussed with the city of Craig Land Development Code:  # Discussed with the city of Craig Land Development Code:  # Discussed with the city of Craig Land Development Code:  # Discussed with the city of Craig Land Development Code:  # Discussed with the city of Craig Land Development Code:  # Discussed with the city of Craig Land Development Code:  # Discussed with the city of Craig Land Development Code:  # Discussed with the city of Craig Land Development Code:  # Discussed with the city of Craig Land Development Code:  # Discussed with the city of Craig Land Development Code:  # Discussed with the city of Craig Land Development Code:  # Discussed with the city of Craig Land Development Code:  # Di	application and state that e City of Craig applicable rmit. Any violation of land becomes void upon compocumented in this application of Craig Municipal with an as-built survey of Date  al. al are made a part of this applicant the applicant of the Craig Municipal with an as-built survey of Date  al. al are made a part of this applicant of this applicant of the Craig Municipal with an as-built survey of Date  al. al are made a part of this applicant of this applicant of the Craig Municipal with an as-built survey of Date  al. al are made a part of this applicant of this applicant of the Craig Municipal with an as-built survey of Date  al. al are made a part of this applicant of this applicant of the Craig Municipal with an as-built survey of Date  al. al are made a part of this applicant of the Craig Municipal with an as-built survey of Date  al. al are made a part of this applicant of the Craig Municipal with an as-built survey of Date  al. al are made a part of this applicant of the Craig Municipal with an as-built survey of Date  al. al are made a part of this applicant of the Craig Municipal with an as-built survey of Date  al. al are made a part of this applicant of the approved wation is not authorized by bleted consistent with this Code.  The lot in the event one is Signature of Property permit as provided by second property and the compliance with a code and all other ordining the building and second property.	s correct. I agree to comply tion, and all land use as are the responsibility rork, or one year, this building permit. applicant or if work does not s completed for this project.  y Owner (if other than applicant) Date ction 18.06.001B.6 of the

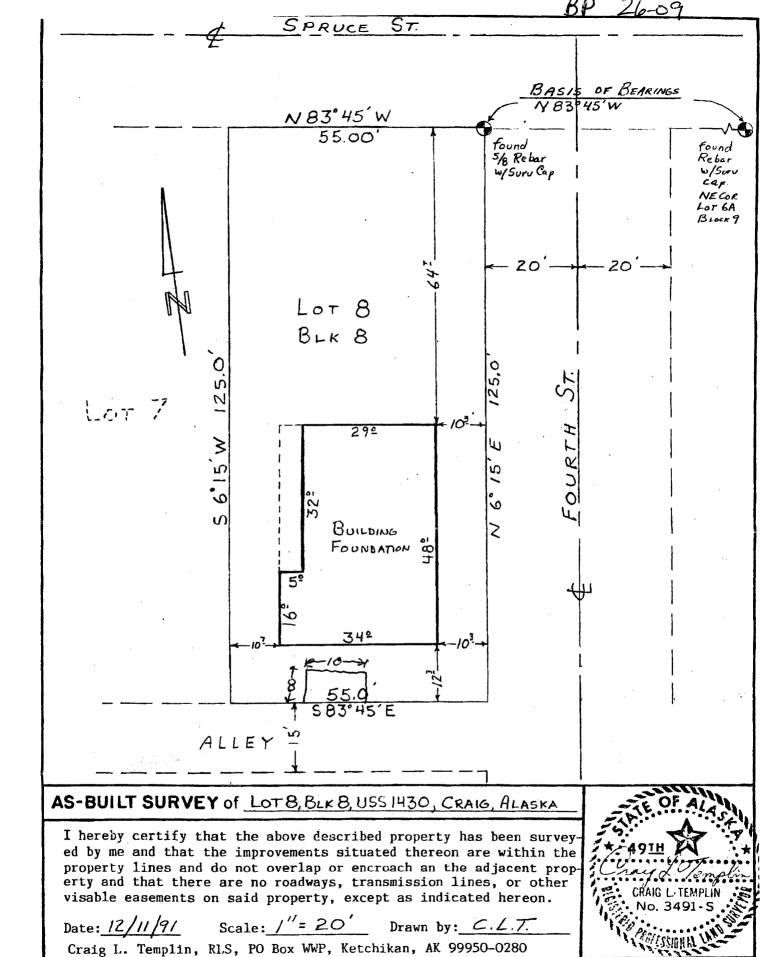

BP 26-09-page 1 of 1

## Scott & Kim Brookshire

From: Plumb, Robert J (DPS) [robert.plumb@alaska.gov]

Sent: Thursday, September 03, 2009 10:14 AM

To: doc31@aptalaska.net; jbolling@aptalaska.net; planner@aptalaska.net

Subject: Southeast dental center

Our office is ok with the proposed accessory shed being built adjacent to the property line due to the alley easement that provides fire separation distance. We do not need to do a plan review for this structure because it is smaller than 120 square feet. IBC Section 105.2 (1)

Robert Plumb
Deputy Fire Marshal I
Department of Public Safety
Division of Fire and Life Safety
2760 Sherwood Lane, STE 1-A
Juneau, AK 99801
(907) 465-4331
(907) 465-5521 fax
Robert.Plumb@alaska.gov