

CITY OF CRAIG, ALASKA BUILDING PERMIT APPLICATION

Applicant Information		Owner Information (if not also applicant)	
Name	Tom Kirkman	Name	
Mailing Address	PO, Box 553	Mailing Address	
Street Address	5.1 mile Pt St Nicholas	Street Address	8th and Cove Street
City, State, Zip	Craig, AK 99921	City, State, Zip	
Telephone	826-5094	Telephone	

Property Description

Subdivision Name: _____

Survey Number: _____ Tract Number: _____ Lot Number: 1A/3 Block Number: 28A

Army Corps of Engineers Permit Name and/or Number: _____

Building Activity Information (please check one)

<input type="checkbox"/> Single Family Home	<input checked="" type="checkbox"/> Duplex's (4)	<input type="checkbox"/> Triplex	<input type="checkbox"/> Fourplex or greater
<input type="checkbox"/> Deck	<input type="checkbox"/> Porch	<input type="checkbox"/> Retaining Wall	<input type="checkbox"/> Addition
<input type="checkbox"/> Commercial Building	<input type="checkbox"/> Wannigan	<input type="checkbox"/> Garage	<input type="checkbox"/> Shed
<input type="checkbox"/> Mobile Home (Year and Make) _____			
<input type="checkbox"/> Travel Trailer (Year and Make) _____			
<input type="checkbox"/> Other (Please describe): _____			

Height of Building at Roof Eave: 18' Closest setback to property line: 10ft

Building Dimensions: 68x32 Area of building footprint: 68x32

What use(s) do you propose for the building? Residential Housing

Site Plan

Please complete on reverse side or attached sheet a site plan showing all proposed construction.

Owner's/Applicant's Statement

I acknowledge that I have read this application and state that the above information is correct. I agree to comply with all codes and ordinances of the City of Craig applicable to building and construction, and all land use regulations as pertaining to this permit. Any violation of land management regulations are the responsibility of the property owner. This permit becomes void upon completion of the approved work, or one year, whichever comes first. Work not documented in this application is not authorized by this building permit. I understand that this permit is revocable if work is not completed consistent with this applicant or if work does not comply with the requirements of the City of Craig Municipal Code. I agree to provide the City of Craig with an as-built survey of the lot in the event one is completed for this project.

Signature of Applicant: [Signature] Date: 1-6-07

Signature of Property Owner (if other than applicant): _____ Date: _____

Special Conditions of Approval.

The following conditions of approval are made a part of this permit as provided by section 18.06.001B.6 of the Craig Land Development Code:


#1. No construction within 10' of property lines.

#2. No construction across property line prior to final approval of replat.

Permission is hereby granted to perform the above work in compliance with any and all conditions listed above and in compliance with the Craig Land Development Code and all other ordinances of the City of Craig and the State of Alaska pertaining to the construction of buildings.


Signature of City Building Official: [Signature] Date: 2-6-07

EIGHTH STREET

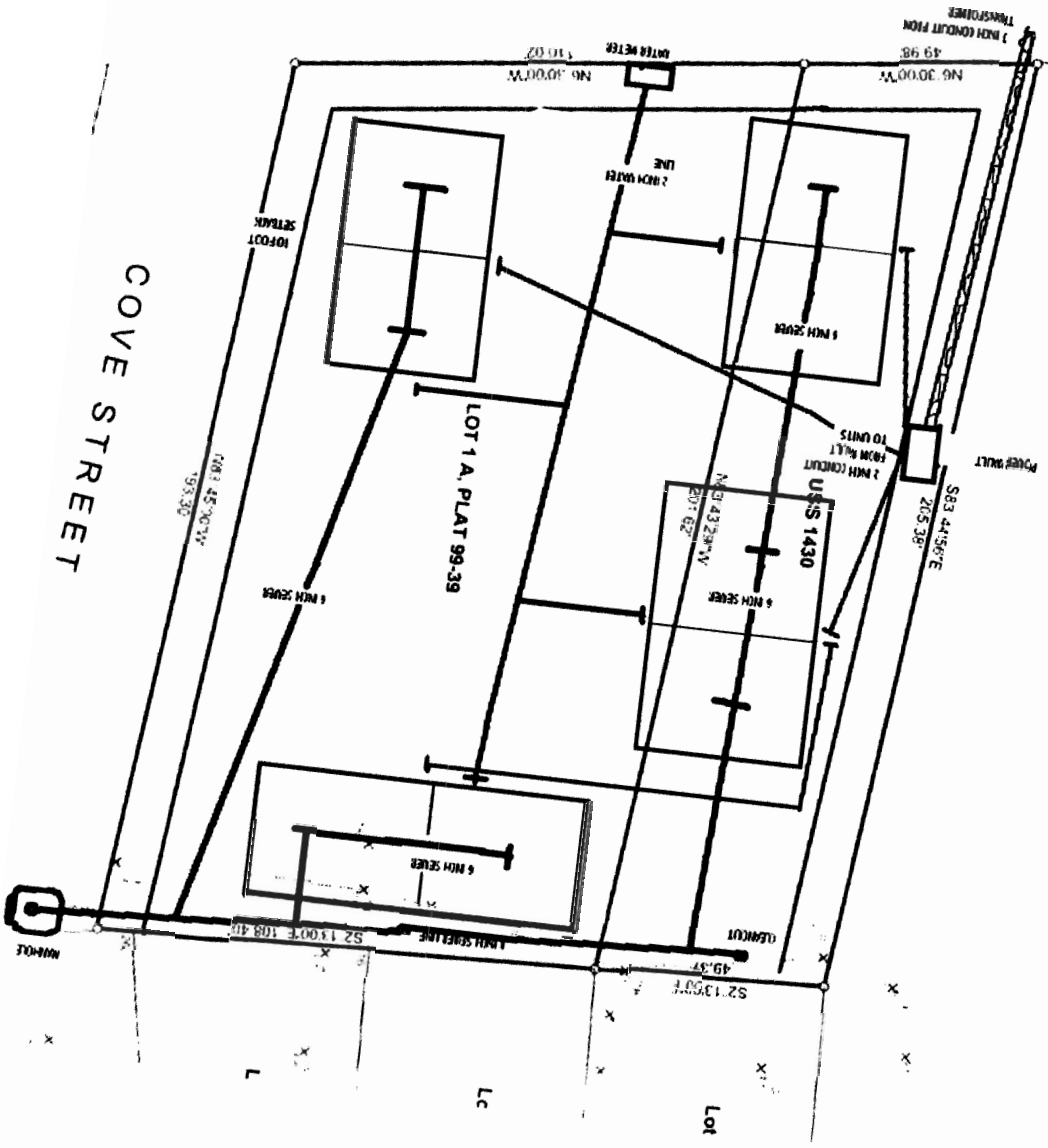

Revised



POSSIBLE LEAN OUT OR CORNER
POSSIBLE HOODS FOR FOOD SERVICE
TO THE NORTH

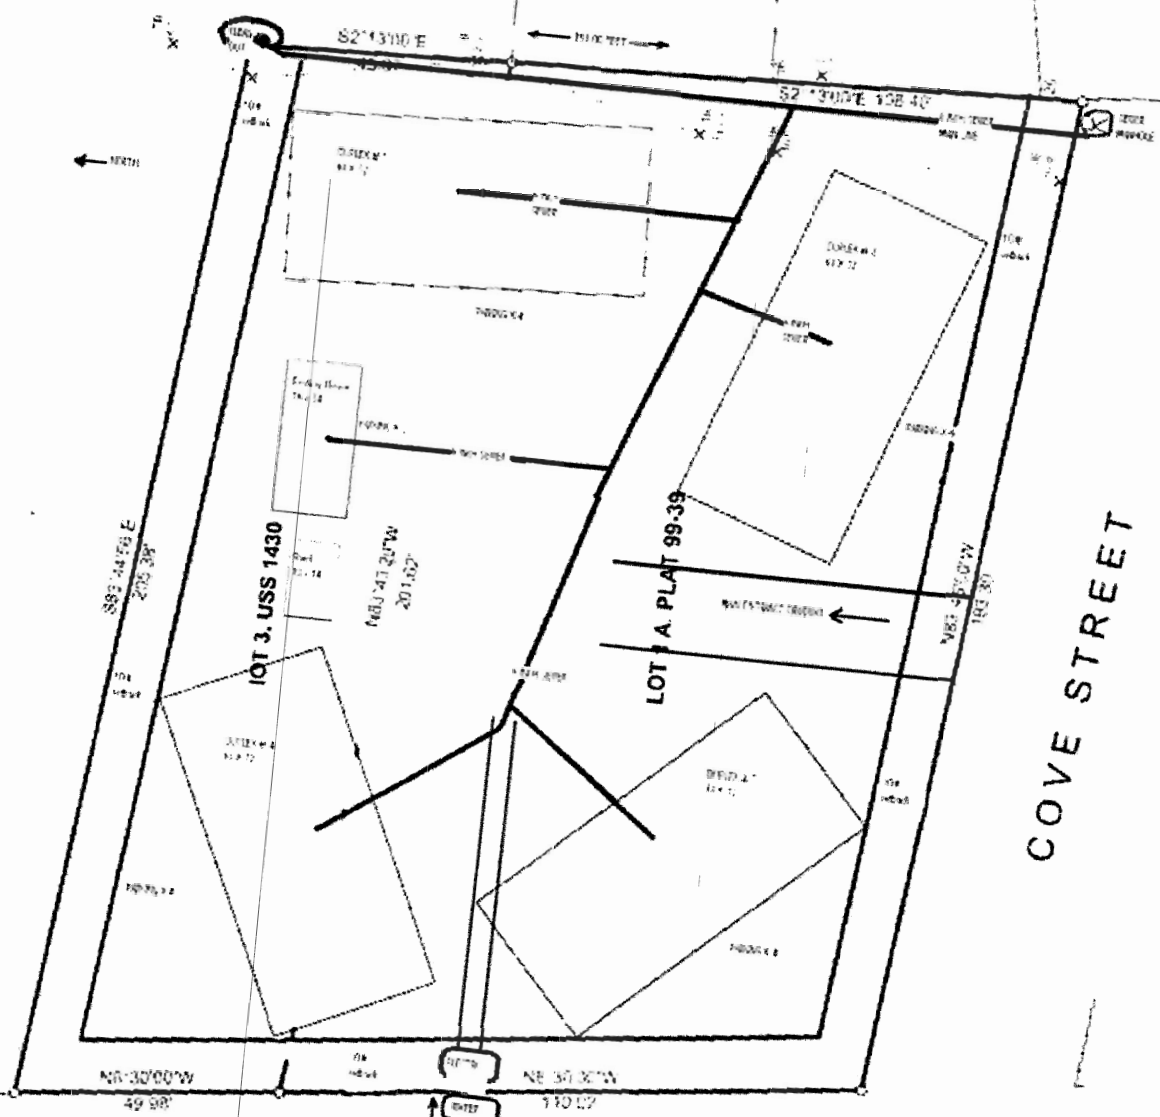

COVE STREET

EIGHTH STREET

ENTER
NO OTHER USES PERMITTED
EXCEPT AS SHOWN

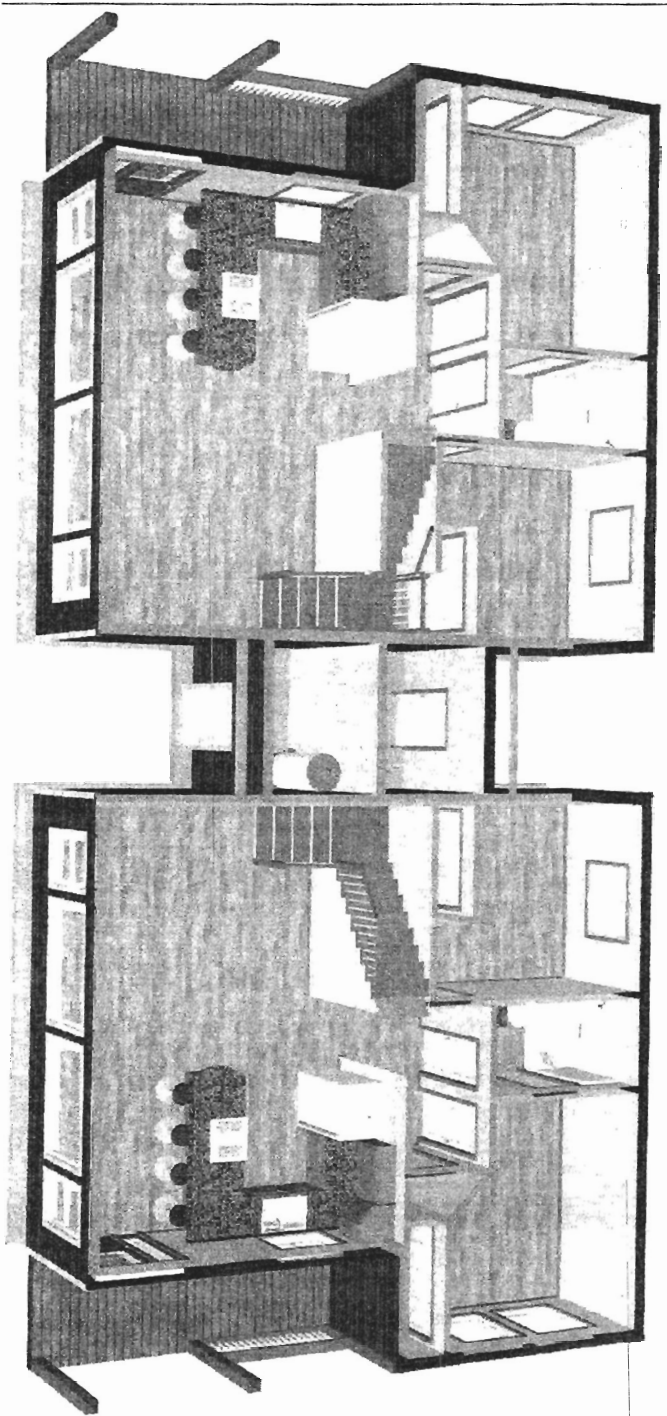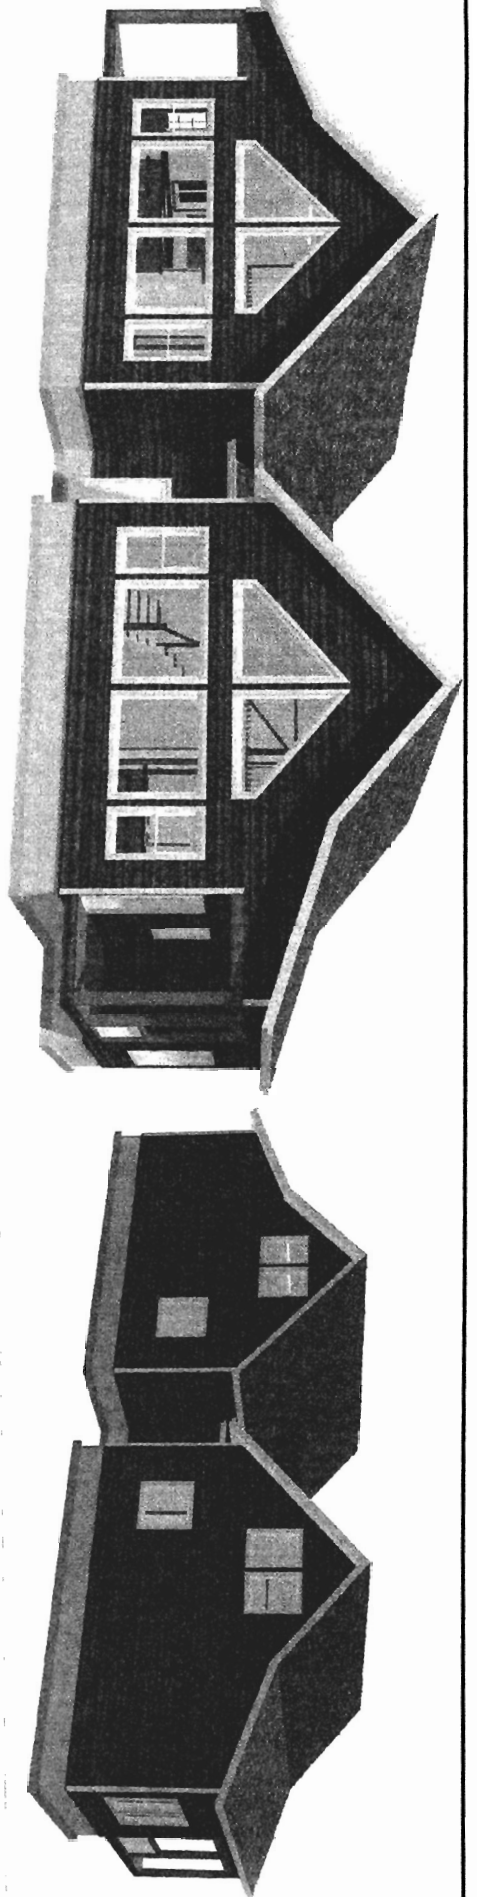

ALL DIMENSIONS PERTAINING TO FINISHING


THESE PLANS HAVE BEEN DRAWN FOR THE CUSTOMER AT THE CUSTOMER'S REQUEST; EXTRA ENGINEERING MAY BE REQUIRED FOR WIND AND SEISMIC LOADS. DESIGNERS RESPONSIBLE FOR ANY AND ALL CHANGES TO THESE PLANS, REGARDING FINISHING, CUSTOMER SHOULD HAVE PLANS REVIEWED BY A LICENSED BUILDER, ENGINEER OR ARCHITECT BEFORE BEGINNING CONSTRUCTION. SOME MODIFICATION MAY BE NECESSARY FOR COMPLIANCE WITH LOCAL AND STATE REGULATIONS.

OWNER'S RENDERINGS
 6884 BIRCH CIRCLE
 KETCHIKAN, AK 99901
 PH: 907-546-0000
 WWW.OWHOMERS.COM

PROJECT NO. _____

COVER _____ DATE/REV: _____
 SCALE: NONE
 SHEET: OF _____

© 2006 OWHOMERS' RENDERINGS

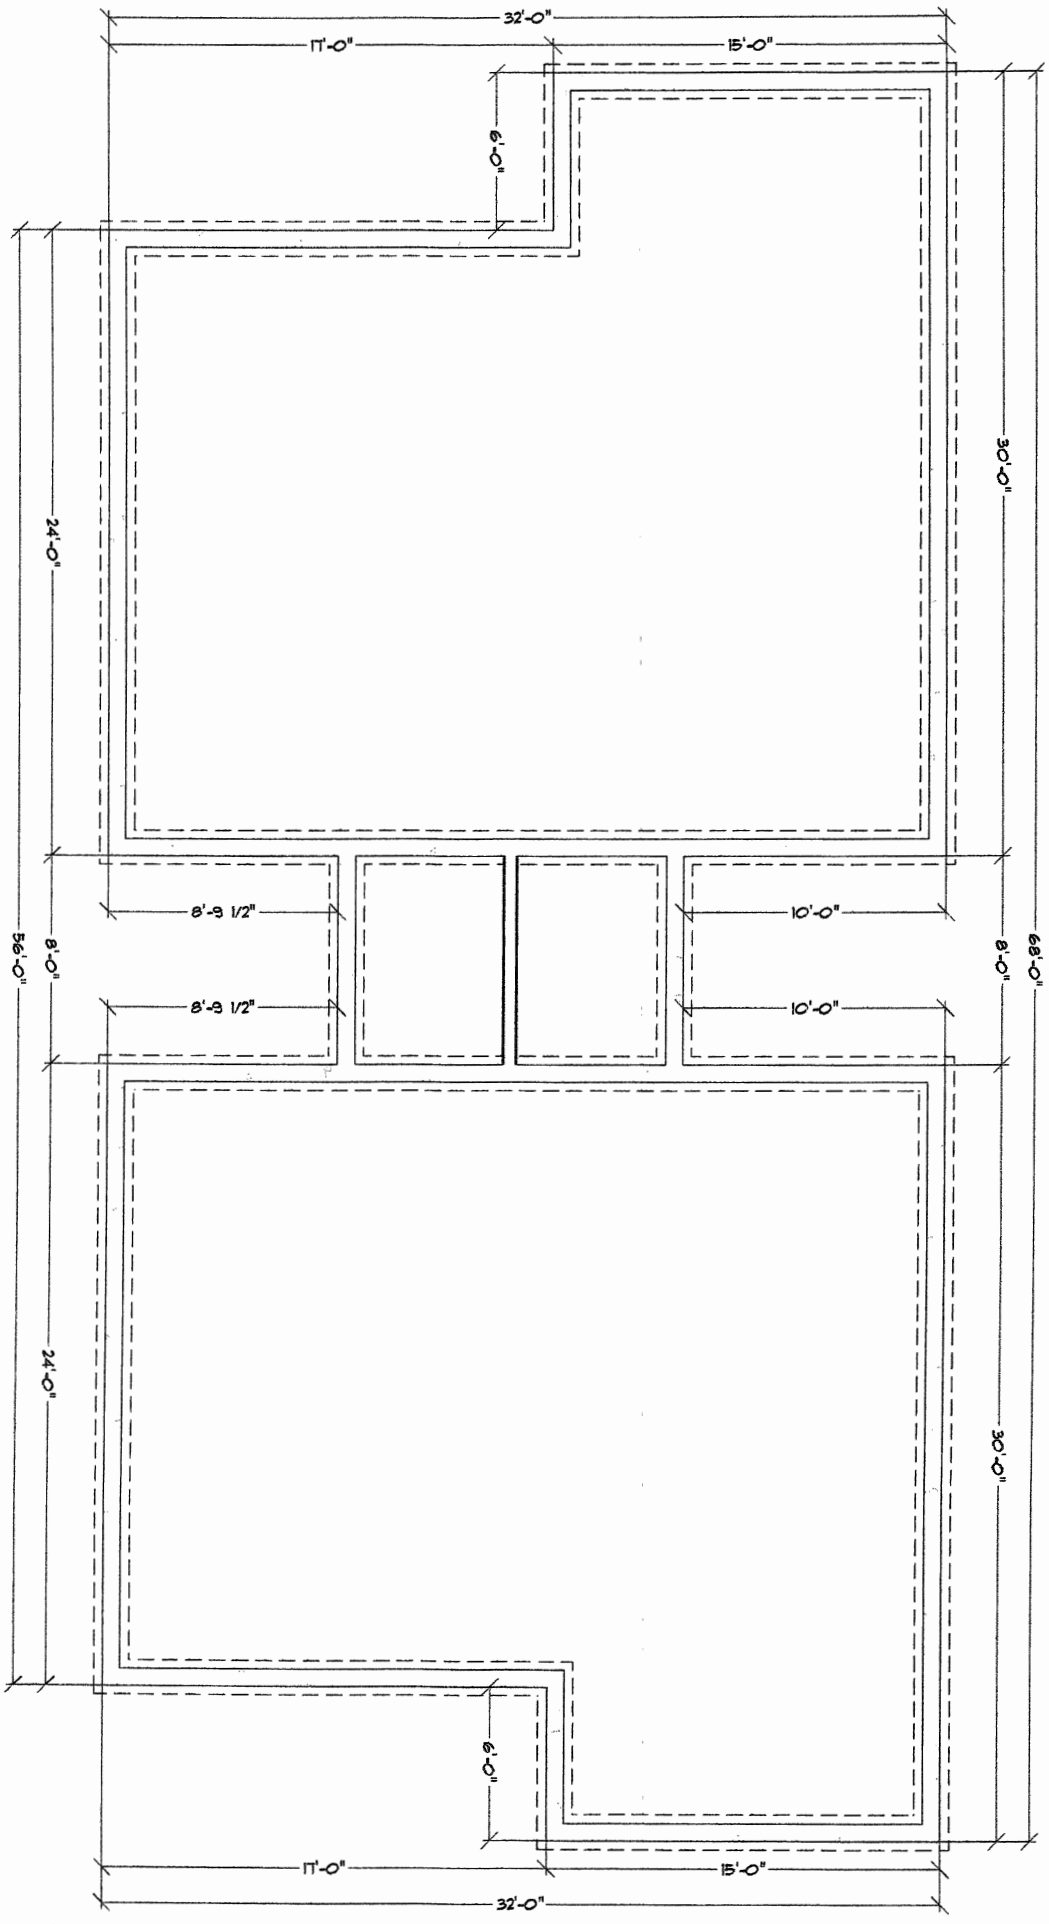

ALL DIMENSIONS FRAMING TO FRAMING

THESE PLANS HAVE BEEN PREPARED FOR THE CUSTOMER AT THE CUSTOMER'S REQUEST. BEFORE SIGNATURE AND SEALING, THE CONTRACTOR SHALL VERIFY THE FOUNDATION DEPTH AND DUE TO A LACK OF CONSTRUCTION AND A LICENSED ENGINEER MAY BE REQUIRED FOR UNDERSIDE FOUNDATION DESIGN. CHRYER'S RENDERINGS TAKES NO LIABILITY EXPRESSED OR IMPLIED REGARDING FLAWS. CUSTOMER SHOULD HAVE PLANS REVIEWED BY A LICENSED BUILDER, ENGINEER OR ARCHITECT BEFORE BEGINNING CONSTRUCTION. SOME MODIFICATION MAY BE NECESSARY FOR COMPLIANCE WITH LOCAL AND STATE REGULATIONS.

CHRYER'S RENDERINGS
 899 BIRCH CIRCLE
 FLETCHER, MO 65031
 email: info@chryers.com

PROJECT FOR:

FOUNDATION PLAN

DATE/REV: _____
 SCALE: 1/4" = 1'
 SHEET: _____ OF _____