

23 DS

333 Cold Storage Rd

CITY OF CRAIG, ALASKA BUILDING PERMIT APPLICATION

Applicant Information		Owner Information (if not also applicant)	
Name <u>Downa Baxter</u>	<u>ALASKA GIFTS</u>	Name <u>THOMAS DIVERSIFIED INVESTMENTS, LLC</u>	
Mailing Address <u>PO Box 1158</u>		Mailing Address <u>2529 RUCKER AVE #100</u>	
Street Address		Street Address	
City, State, Zip <u>CRAIG, AK 99921</u>		City, State, Zip <u>EVERETT, WA 98201</u>	
Telephone <u>907-826-2791</u>		Telephone <u>425-559-5638</u>	

Property Description

Subdivision Name WOODWIND PLAZA 5 & 6

Survey Number: 455 2327 Tract Number: 2A-A Lot Number: _____ Block Number: _____

Army Corps of Engineers Permit Name and/or Number: _____

Building Activity Information (please check one)

<input type="checkbox"/> Single Family Home	<input type="checkbox"/> Duplex	<input type="checkbox"/> Triplex	<input type="checkbox"/> Fourplex or greater
<input type="checkbox"/> Deck	<input type="checkbox"/> Porch	<input type="checkbox"/> Retaining Wall	<input type="checkbox"/> Addition
<input checked="" type="checkbox"/> Commercial Building	<input type="checkbox"/> Wannigan	<input type="checkbox"/> Garage	<input type="checkbox"/> Shed
<input type="checkbox"/> Mobile Home (Year and Make): _____			
<input type="checkbox"/> Travel Trailer (Year and Make): _____			
<input type="checkbox"/> Other (Please describe): _____			

Height of Building at Roof Eave: _____ Closest setback to property line: _____

Building Dimensions: _____ Area of building footprint: _____

What use(s) do you propose for the building? _____

Site Plan

Please complete on reverse side or attached sheet a site plan showing all proposed construction.

Owner's/Applicant's Statement

I acknowledge that I have read this application and state that the above information is correct. I agree to comply with all codes and ordinances of the City of Craig applicable to building and construction, and all land use regulations as pertaining to this permit. Any violation of land management regulations are the responsibility of the property owner. This permit becomes void upon completion of the approved work, or one year, whichever comes first. Work not documented in this application is not authorized by this building permit. I understand that this permit is revocable if work is not completed consistent with this applicant or if work does not comply with the requirements of the City of Craig Municipal Code. I agree to provide the City of Craig with an as-built survey of the lot in the event one is completed for this project.

Downa Baxter 9-14-05 Craig (Signature) 9-15-05
 Signature of Applicant Date Signature of Property Owner (if other than applicant) Date

Special Conditions of Approval.


The following conditions of approval are made a part of this permit as provided by section 18.08.001B.8 of the Craig Land Development Code:

Removal of interior wall between old Tongass Business Center
at 2/3rd way from San. Condition above two tables above
to 1/3rd way at far of bldg and completely re-carpet

Fire Marshall Review Required (Contact Fire Marshall Robert Plumb @ 907-465-5522)
Prior to Occupancy.

Permission is hereby granted to perform the above work in compliance with any and all conditions listed above and in compliance with the Craig Land Development Code and all other ordinances of the City of Craig and the State of Alaska pertaining to the construction of buildings.

Signature of City Building Official [Signature] Date 9-19-05

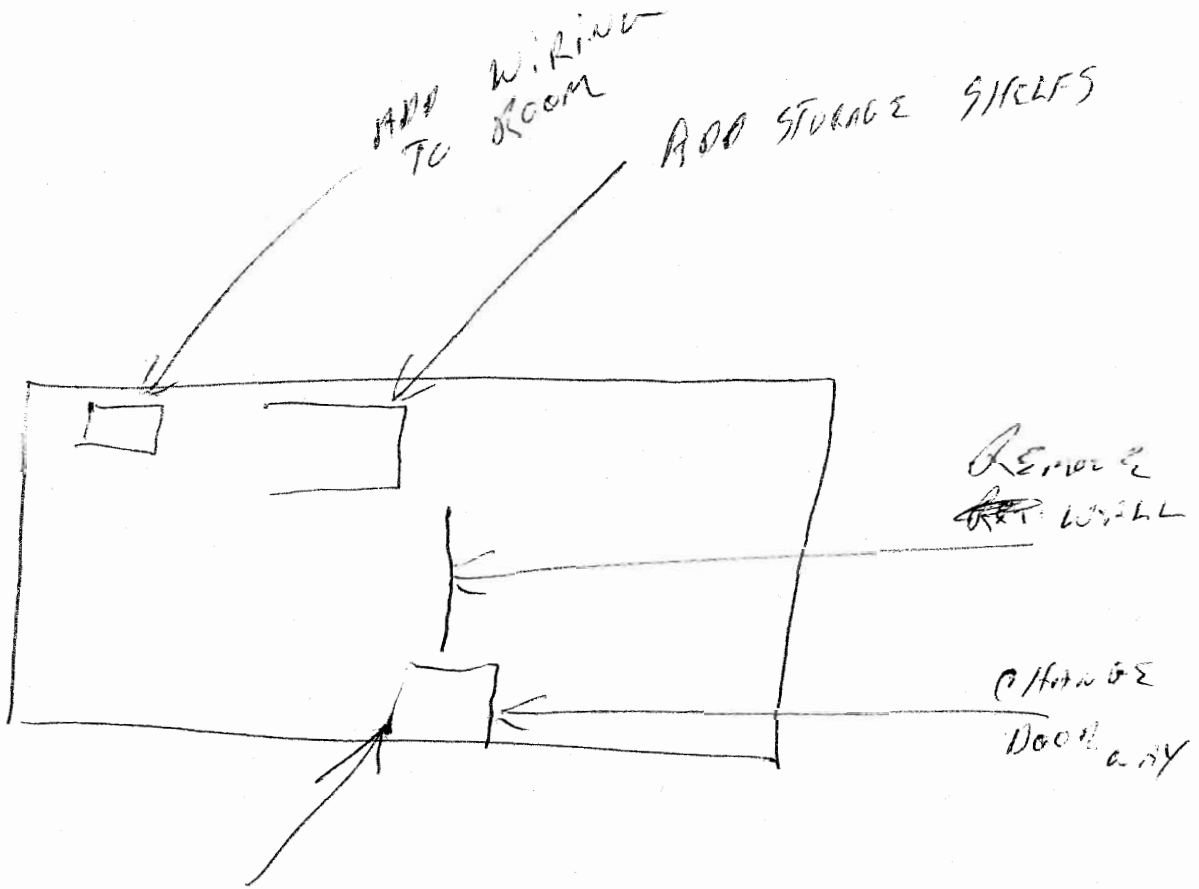

REWIRE
LIGHT SWITCHES