
91-04 (R)

## CITY OF CRAIG, ALASKA BUILDING PERMIT APPLICATION

| Applicant Information  | Owner Information (if not also applicant)                  |
|--|--|
| Name Gail Stenta   | Name   |
| Mailing Address Po Box 98  |  |
| Street Address   | Mailing Address  |
|  | Street Address   |
| City, State, Zip Craig Ak. 99921   | City, State, Zip   |
| Telephone 907-826-2333   | Telephone  |
| Property Description   |  |
| Subdivision Name (raia Jownsite  |  |
| Survey Number: VSS 14 30 Tract Number:   | Block Number: 21 Lot Number: 5                             |
| Army Corps of Engineers Permit Name and/or Number:   | block Number. 21 Lot Number.                               |
|  |  |
|  |  |
| Building Activity Information (please check one)   |  |
| ☐ Single Family Home ☐ Duplex  | ☐ Triplex ☐ Fourplex or greater                            |
| Deck Porch   | ☐ Retaining Wall ☐ Addition                                |
| Commercial Building Wannigan   | ☐ Garage ☐ Shed  |
| ☐ Mobile Home (Year and Make)  |  |
| ☐ Travel Trailer (Year and Make)   |  |
| Mother (Please describe): Damo Partion of  | building to create parking, repair wall,                   |
| *\001, etc.  |  |
| Height of Building at Roof Eve:  | Closest setback to property line:                          |
| Building Dimensions:   | Area of building footprint: 2400 5.F.                      |
| What use(s) do you propose for the building? $\mathcal{R}_{a}$ +   | ail Rentals  |
|  |  |
| [a., a.  |  |
| Site Plan  | ·  |
| Elegas complete on voyers side or etteched share   | to site plan abouting all proposed construction            |
| ☐ Please complete on reverse side or attached shee   | t a site plan snowing all proposed construction.           |
|  |  |
| I acknowledge that I have read this application and state that the above information is correct. I agree to comply with all codes and ordinances of the City of Craig applicable to building and construction, and all land use regulations as pertaining to this permit. Any violation of land management regulations are the responsibility of the property owner. This permit becomes void upon completion of the approved work, or one year, whichever comes first. Work not documented in this application is not authorized by this building permit.  I understand that this permit is revocable if work is not completed consistent with this applicant or if work does not comply with the requirements of the City of Craig Municipal Code.  I agree to provide the City of Craig with an as-built survey of the lot in the event one is completed for this project.  |  |
| Signature of Applicant Date  | Signature of Property Owner (if other than applicant) Date |
| Special Conditions of Approval.  The following conditions of approval are made a part of this permit as provided by section 18.06.001B.6 of the Craig Land Development Code:    Development Code:   Developmen |  |
|  |  |
|  |  |
| Permission is hereby granted to perform the above work in compliance with any and all conditions listed above and in compliance with the Craig Land Development Code and all other ordinances of the City of Craig and the State of Alaska pertaining to the construction of buildings.  |  |
| M. M. I.   |  |
| Signature of City Building Official  | Date 1-6-04  |

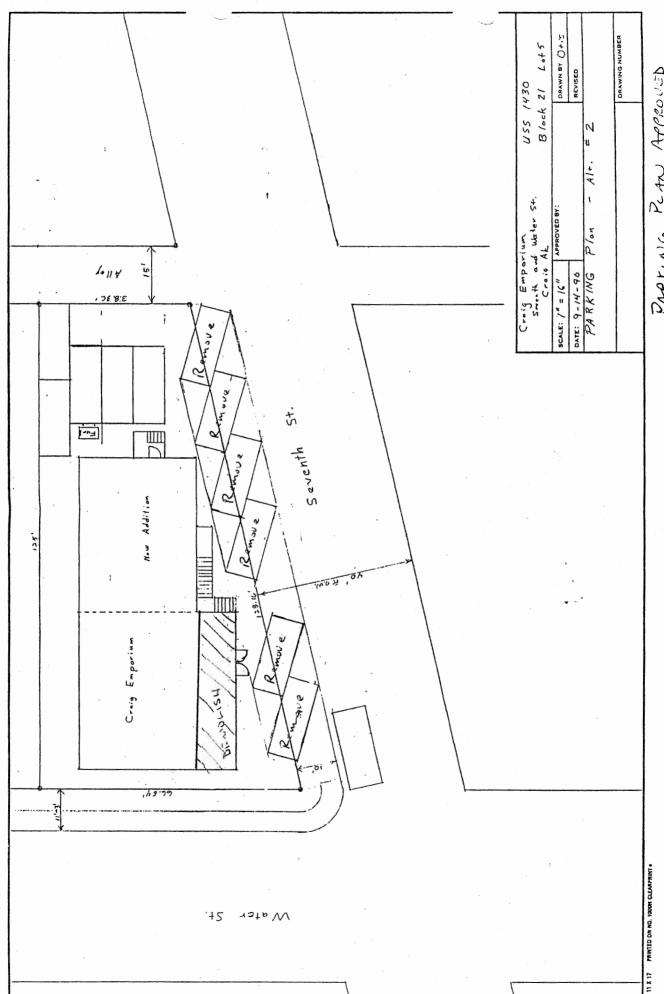

PAREING PLAN APPROVED BY VARIANCE UPO-7-2 9/27/90