

**CITY OF CRAIG, ALASKA  
BUILDING PERMIT APPLICATION**

36-04

<b>Applicant Information</b>		<b>Owner Information (if not also applicant)</b>	
Name	Fred Ensign	Name	Terri Dichoso
Mailing Address	P.O. 238	Mailing Address	P.O. 261
Street Address		Street Address	
City, State, Zip	Craig, Alaska 99921	City, State, Zip	Craig, Alaska 99921
Telephone	907 826 2894	Telephone	

**Property Description**

Subdivision Name \_\_\_\_\_

Survey Number: VSS 2611 Tract Number: \_\_\_\_\_ Block Number: 22 Lot Number: 2

Army Corps of Engineers Permit Name and/or Number: \_\_\_\_\_

**Building Activity Information (please check one)**

<input checked="" type="checkbox"/> Single Family Home	<input type="checkbox"/> Duplex	<input type="checkbox"/> Triplex	<input type="checkbox"/> Fourplex or greater
<input type="checkbox"/> Deck	<input type="checkbox"/> Porch	<input type="checkbox"/> Retaining Wall	<input type="checkbox"/> Addition
<input type="checkbox"/> Commercial Building	<input type="checkbox"/> Wannigan	<input type="checkbox"/> Garage	<input type="checkbox"/> Shed
<input type="checkbox"/> Mobile Home (Year and Make) _____			
<input type="checkbox"/> Travel Trailer (Year and Make) _____			
<input type="checkbox"/> Other (Please describe): _____			

Height of Building at Roof Eave: 21' 6" - Base of Footing to Eave Closest setback to property line: 11'

Building Dimensions: 28' x 46' Area of building footprint: 1288 sq. ft (43%)

What use(s) do you propose for the building? Single Family Dwelling & in-home salon business

**Site Plan**

Please complete on reverse side or attached sheet a site plan showing all proposed construction.

**Owner's/Applicant's Statement**

I acknowledge that I have read this application and state that the above information is correct. I agree to comply with all codes and ordinances of the City of Craig applicable to building and construction, and all land use regulations as pertaining to this permit. Any violation of land management regulations are the responsibility of the property owner. This permit becomes void upon completion of the approved work, or one year, whichever comes first. Work not documented in this application is not authorized by this building permit. I understand that this permit is revocable if work is not completed consistent with this applicant or if work does not comply with the requirements of the City of Craig Municipal Code. I agree to provide the City of Craig with an as-built survey of the lot in the event one is completed for this project.

<p><u>Fred T. Ensign</u> <u>Oct 4, 2004</u></p> <p>Signature of Applicant Date</p>	<p><u>Terri Dichoso</u> <u>Oct 4, 2004</u></p> <p>Signature of Property Owner (if other than applicant) Date</p>
--	--


**Special Conditions of Approval.**

The following conditions of approval are made a part of this permit as provided by section 18.06.001B.6 of the Craig Land Development Code:

#1. Average Distance from finished grade to deck level must be less than 30"

#2. Driveway on westerly edge of property (8th st) is authorized. Driveway will start at main st and terminate at Lot 2, Block 22, VSS 2611. Driveway construction must be coordinated with City Public Works.

# General Appearance with Changes Listed

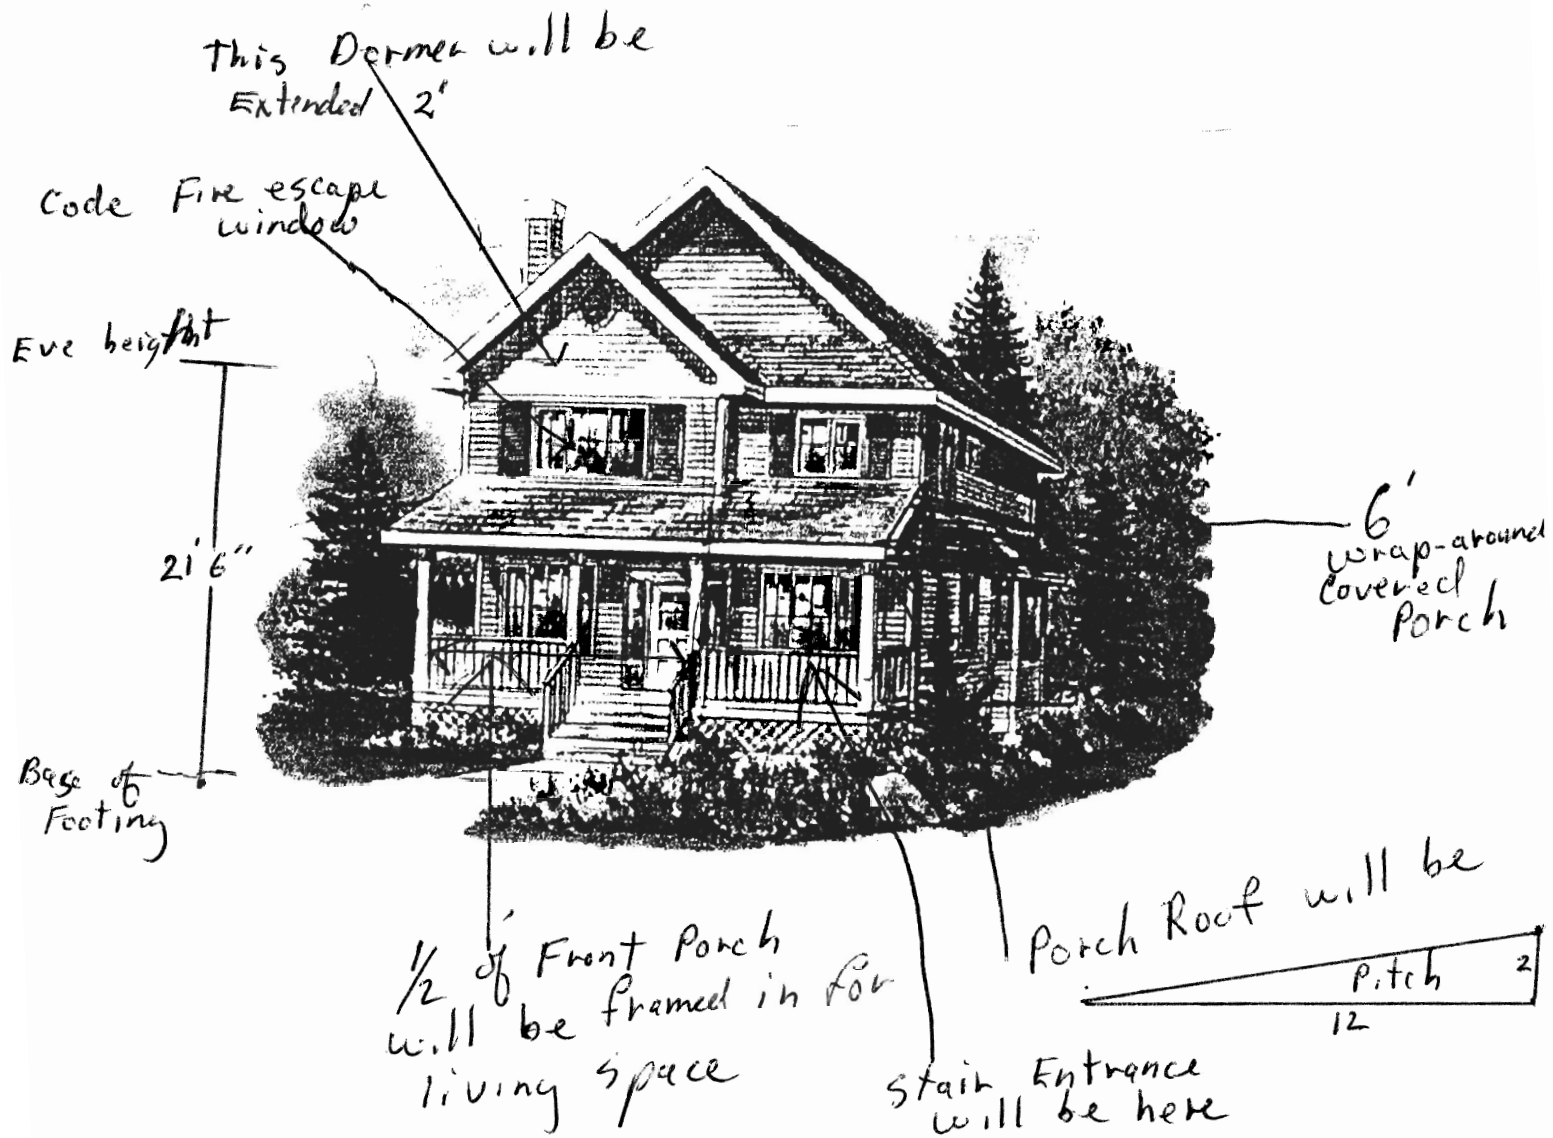

House Facing South Cove



Site Location

Power North Pole

51.13 F

16' Driveway

Apex

ROCK Bulkhead

Lot 2

House

Location of 4" line  
Sewer & 1/2" - 3/4" line

Lot 3

Langdon

Lot 1


Power Pole

Porch Wall with 2' overhang  
Beyond this point, overhang roof will be 3' from property line!

Apex


50 FT

10

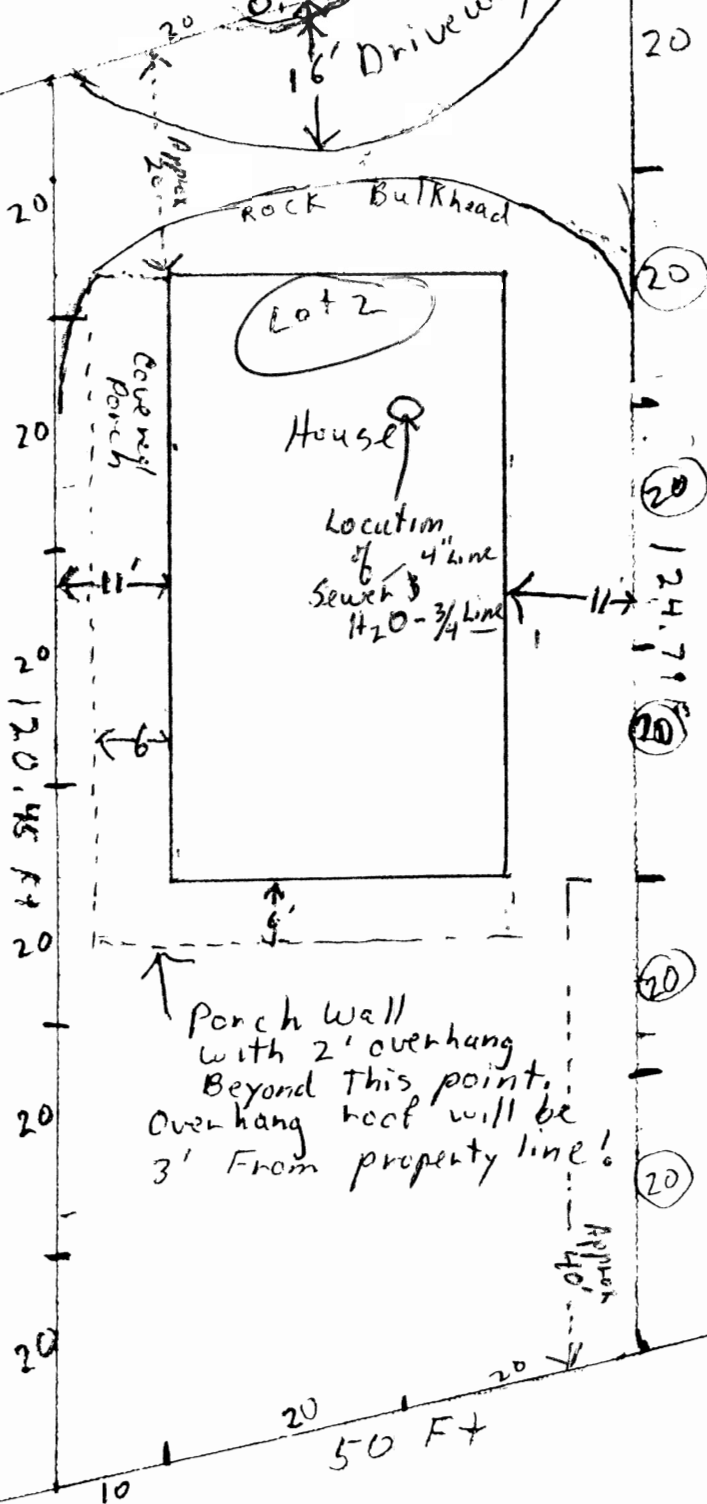

# Main Floor


← 28 → \* 6 →

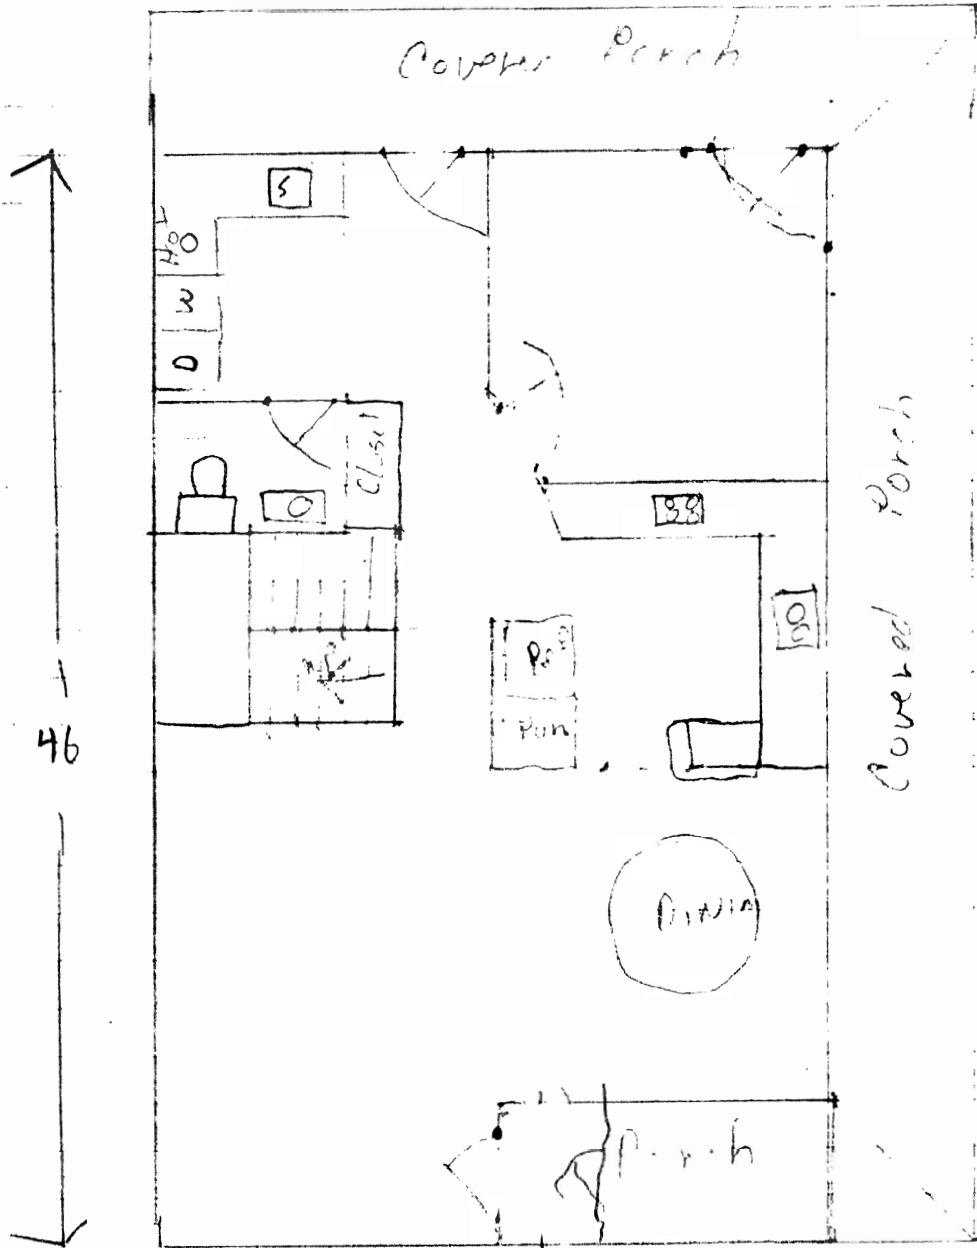

1/2 South Cove

Up stairs

28

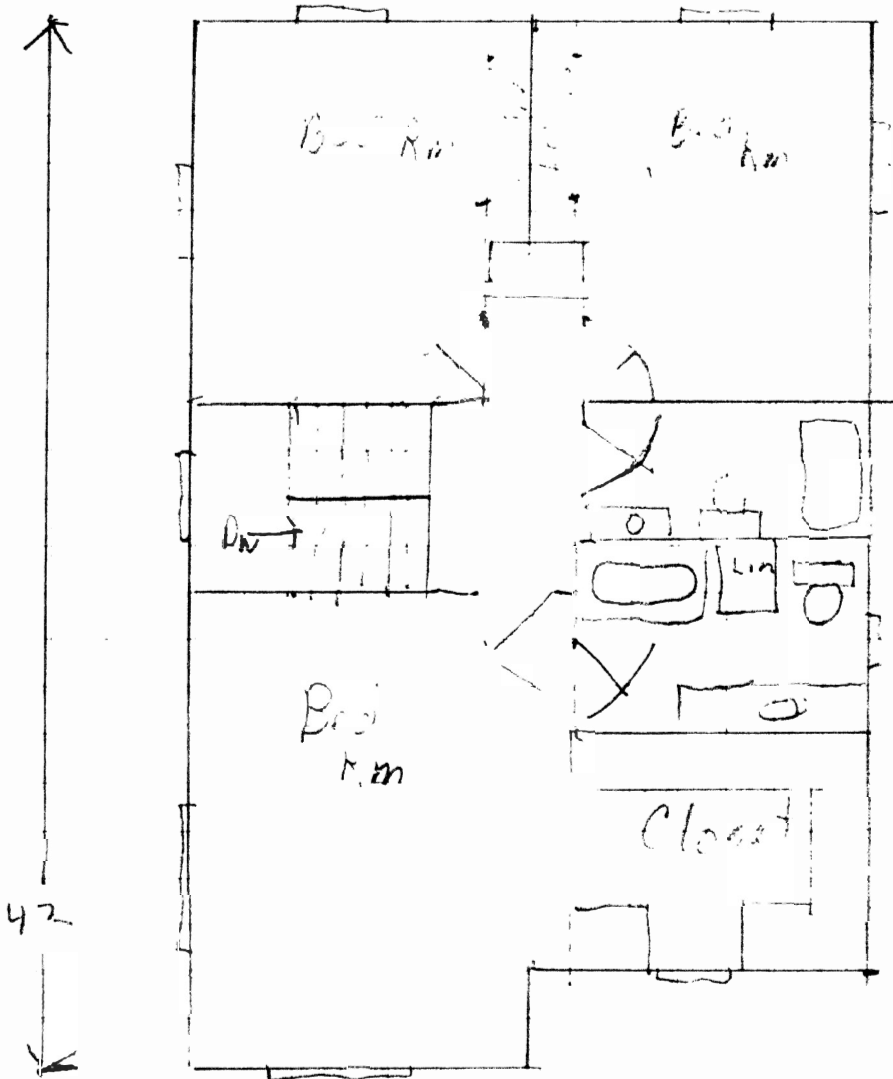

42

South Side